


WATER WELL RECORD Form WWC-5 KSA 82A-1212

1 LOCATION OF WATER WELL: COUNTY: 042 HODGEMAN FRACTION: NW 1/4 SW 1/4 SE 1/4 SECTION NUMBER: 36 TOWNSHIP NUMBER: T 22 RANGE NUMBER: R 24

DISTANCE AND DIRECTION FROM NEAREST TOWN OR CITY STREET ADDRESS OF WELL IF LOCATED WITHIN CITY?
FROM JETMORE; PPX 3/4 MILE WEST & 1/4 MILE NORTH

2 WATER WELL OWNER: BILL GOEBEL RR#, St. Address, Box #: PO BOX 653 BOARD OF AGRICULTURE, DIVISION OF WATER RESOURCES CITY, STATE, ZIP CODE: JETMORE, KS 67854- APPLICATION NUMBER: 43,698

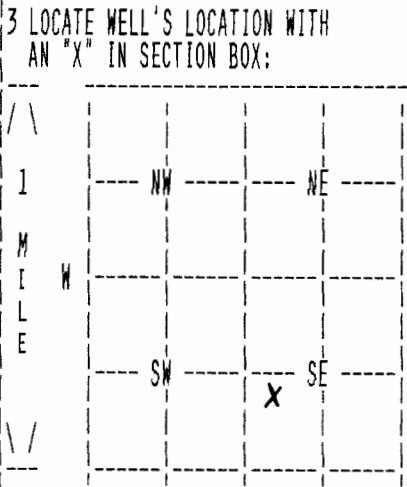

4 DEPTH OF COMPLETED WELL 442 ELEVATION: 0
DEPTH(S) GROUNDWATER ENCOUNTERED 1. 0 FT. 2. 0 FT. 3. 0 FT.
WELL'S STATIC WATER LEVEL 188 FT. BELOW LAND SURFACE MEASURED ON MO/DAY/YR 09/30/00
PUMP TESTDATA: WELL WATER WAS 305 FT. AFTER 4 HOURS PUMPING 1139 GPM
ESTIMATED YIELD 0 GPM: WELL WATER WAS 0 FT. AFTER 0 HOURS PUMPING 0 GPM
BORE HOLE DIAMETER 22 IN. TO 442 FT., AND IN. TO 0 FT.
WELL WATER TO BE USED AS: 05 PUB. WTR SUP
WAS A CHEMICAL/BACTERIOLOGICAL SAMPLE SUBMITTED TO DEPARTMENT? No ;
IF YES, MO/DAY/YR SAMPLE WAS SUBMITTED WATER WELL DISINFECTED? Yes

5 TYPE OF BLANK CASING USED: 02 PVC CASING JOINTS: GLUED
BLANK CASING DIAMETER 12 IN. TO 442 FT., DIA IN. TO 0 FT., DIA IN. TO 0 FT.
CASING HEIGHT ABOVE LAND SURFACE 12 IN., WEIGHT 15 LBS/FT. WALL THICKNESS OR GAUGE NO. .606
TYPE OF SCREEN OR PERFORATION MATERIAL: 07 PVC
SCREEN OR PERFORATION OPENINGS ARE: 03 MILL SLOT

SCREEN PERFORATED INTERVALS: FROM 312 FT. TO 432 FT., FROM 0 FT. TO 0 FT.
GRAVEL PACK INTERVALS: FROM 0 FT. TO 0 FT., FROM 0 FT. TO 0 FT.
FROM 20 FT. TO 442 FT., FROM 0 FT. TO 0 FT.
FROM 0 FT. TO 0 FT., FROM 0 FT. TO 0 FT.

6 GROUT MATERIAL 02 CEMENT GROUT
GROUT INTERVALS: FROM 0 FT. TO 20 FT., FROM 0 FT. TO 0 FT., FROM 0 FT. TO 0 FT.
WHAT IS THE NEAREST SOURCE OF POSSIBLE CONTAMINATION: NONE OBSERVED
DIRECTION FROM WELL? HOW MANY FEET? 0

FROM	TO	LITHOLOGIC LOG	FROM	TO	PLUGGING INTERVALS
0	2	02 SILT			
2	30	31 CALICHE 20 LIMESTONE			
16	188	19 SHALE			
60	129	19 SHALE 31 CALICHE			
129	135	19 SHALE 20 LIMESTONE			
135	143	19 SHALE 23 SANDSTONE			
143	155	19 SHALE			
155	162	19 SHALE 23 SANDSTONE			
162	170	19 SHALE			
170	176	23 SANDSTONE 20 LIMESTONE			

7 CONTRACTOR'S OR LANDOWNER'S CERTIFICATION: THIS WATER WELL WAS CONSTRUCTED UNDER MY JURISDICTION AND WAS COMPLETED ON (MO/DAY/YEAR) 09/28/00 AND THIS RECORD IS TRUE TO THE BEST OF MY KNOWLEDGE AND BELIEF. KANSAS WATER WELL CONTRACTOR'S LICENSE NO. 145 THIS WATER WELL RECORD WAS COMPLETED ON (MO/DAY/YR) 11/30/00 UNDER THE BUSINESS NAME OF HENKLE DRILLING & SUPPLY BY (SIGNATURE)

(CONTINUED)

WATER WELL RECORD Form WWC-5 KSA 82A-1212

1 LOCATION OF WATER WELL: COUNTY: 042 HODGEMAN	FRACTION NW 1/4 SW 1/4 SE 1/4	SECTION NUMBER 36	TOWNSHIP NUMBER T 22 S	RANGE NUMBER R 24 W
---	----------------------------------	----------------------	---------------------------	------------------------

2 WATER WELL OWNER: BILL GOEBEL
 RR#, St. Address, Box #: PO BOX 653
 BOARD OF AGRICULTURE, DIVISION OF WATER RESOURCES

CITY, STATE, ZIP CODE : JETHORE, KS 67854- APPLICATION NUMBER: 43,698

FROM	TO	LITHOLOGIC LOG
188	192	23 SANDSTONE
192	203	19 SHALE
203	212	23 SANDSTONE 19 SHALE
212	228	19 SHALE 01 CLAY
228	235	23 SANDSTONE
235	310	19 SHALE 01 CLAY 23 SANDSTONE
310	398	23 SANDSTONE 19 SHALE 01 CLAY
398	408	23 SANDSTONE 07 FINE SAND
408	432	23 SANDSTONE 19 SHALE
432	440	19 SHALE 20 LIMESTONE 23 SANDSTONE

7 CONTRACTOR'S OR LANDOWNER'S CERTIFICATION: THIS WATER WELL WAS CONSTRUCTED UNDER MY JURISDICTION AND WAS COMPLETED ON (MO/DAY/YEAR) 09/28/00 AND THIS RECORD IS TRUE TO THE BEST OF MY KNOWLEDGE AND BELIEF. KANSAS WATER WELL CONTRACTOR'S LICENSE No. 145 THIS WATER WELL RECORD WAS COMPLETED ON (MO/DAY/YR) 11/30/00 UNDER THE BUSINESS NAME OF HENKLE DRILLING & SUPPLY BY (SIGNATURE) *Bruce J. Reichmuth*