


WATER WELL RECORD Form WWC-5 KSA 82a-1212

1 LOCATION OF WATER WELL: Fraction Section Number Township Number Range Number
 COUNTY: HODGEMAN SE 1/4 SE 1/4 SE 1/4 25 T 22 S R 24 W

Distance and direction from nearest town or city street address of well if located within city?
 FROM JETMORE - 1 MILE NORTH ON HIGHWAY 283 - 1/4 WEST

2 WATER WELL OWNER: CRAGHEAD, DARRELL
 RR#, St. Address, Box #: RR #1 Board of Agriculture, Division of Water Resources
 City, State, ZIP code: JETMORE, KS 67854- Application Number:

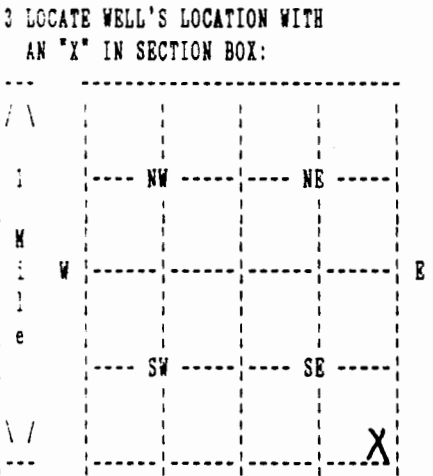

4 DEPTH OF COMPLETED WELL 445 ELEVATION: 0
 Depth(s) Groundwater Encountered 1. 0 ft. 2. 0 ft. 3. 0 ft.
 WELL'S STATIC WATER LEVEL 139 ft. below land surface measured on mo/day/yr 06/12/03
 Pump testdata: Well water was 0 ft. after 0 hours pumping 0 gpm
 Estimated Yield 75 gpm: Well water was 0 ft. after 0 hours pumping 0 gpm
 Bore Hole Diameter 10 in. to 445 ft., and in. to 0 ft.
 WELL WATER TO BE USED AS: DOMESTIC
 Was a chemical/bacteriological sample submitted to department? No ;
 If yes, mo/day/yr sample was submitted Water well disinfected? Yes

5 TYPE OF BLANK CASING USED: CERTA LOC CASIN CASING JOINTS: CERTA-LOC
 Blank casing diameter 5 in. to 445 ft., Dia in. to 0 ft., Dia in. to 0 ft.
 Casing height above land surface 200 in., weight 12 lbs/ft. Wall thickness or gauge No. 21 17
 TYPE OF SCREEN OR PERFORATION MATERIAL: *Certa-Loc*
 SCREEN OR PERFORATION OPENINGS ARE: SAW CUT

SCREEN PERFORATED INTERVALS: From 380 ft. to 440 ft., From 0 ft. to 0 ft.
 From 0 ft. to 0 ft., From 0 ft. to 0 ft.
 GRAVEL PACK INTERVALS: From 26 ft. to 445 ft., From 0 ft. to 0 ft.
 From 0 ft. to 0 ft., From 0 ft. to 0 ft.

6 GROUT MATERIAL BENTONITE
 Grout Intervals: From 5 ft. to 26 ft., From 0 ft. to 0 ft., From 0 ft. to 0 ft.
 What is the nearest source of possible contamination: NONE
 Direction from well? How many feet? 0

FROM	TO	LITHOLOGIC LOG	FROM	TO	PLUGGING INTERVALS
0	20	01 TOPSOIL 05 CLAY 02 FINE SAND			
20	40	10 FINE-MEDSAND 05 CLAY			
40	160	07 BLUE SHALE			
160	190	36 BLUE CLAY			
190	200	29 SANDSTONE			
200	220	29 SANDSTONE 16 GRAY CLAY 26 RED CLAY			
220	240	16 GRAY CLAY 26 RED CLAY 29 SANDSTONE			
240	260	16 GRAY CLAY 29 SANDSTONE			
260	450	29 SANDSTONE			

7 CONTRACTOR'S OR LANDOWNER'S CERTIFICATION: This water well was Constructed under my jurisdiction and was completed on (mo/day/year) 06/13/03 and this record is true to the best of my knowledge and belief. Kansas Water Well Contractor's License No. 179 This Water Well Record was completed on (mo/day/yr) 06/24/03 under the business name of JOB'S WELL SERVICE, INC. by (signature) *Justin Cook*