


WATER WELL RECORD Form WWC-5 KSA 82a-1212

1 LOCATION OF WATER WELL: Fraction Section Number Township Number Range Number  
 COUNTY: HODGEMAN NE 1/4 NE 1/4 NE 1/4 32 T 22 S R 24 W

Distance and direction from nearest town or city street address of well if located within city?  
 FROM JETMORE ON HIGHWAY 156 - 5 WEST, 1 NORTH & 1/4 WEST

2 WATER WELL OWNER: BLOTE, LOIS  
 RR#, St. Address, Box #: 108 S. TAYLOR Board of Agriculture, Division of Water Resources  
 City, State, ZIP code: PRATT, KS 67124- Application Number:

3 LOCATE WELL'S LOCATION WITH AN "X" IN SECTION BOX: 4 DEPTH OF COMPLETED WELL 575 ELEVATION: 0  
 Depth(s) Groundwater Encountered 1. 0 ft. 2. 0 ft. 3. 0 ft.

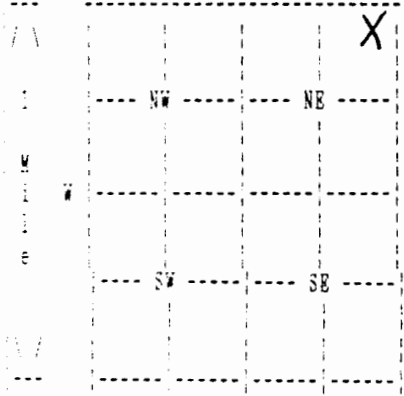

WELL'S STATIC WATER LEVEL 238 ft. below land surface measured on mo/day/yr 09/12/05  
 Pump test data: Well water was 0 ft. after 0 hours pumping 0 gpm

Estimated Yield 30 gpm: Well water was 0 ft. after 0 hours pumping 0 gpm

Bore Hole Diameter 10 in. to 575 ft., and in. to 0 ft.

WELL WATER TO BE USED AS: DOMESTIC

Was a chemical/bacteriological sample submitted to department? No ;  
 If yes, mo/day/yr sample was submitted Water well disinfected? Yes

5 TYPE OF BLANK CASING USED: CERTA LOC CASIN CASING JOINTS: CERTA-LOC  
 Blank casing diameter 5 in. to 575 ft., Dia in. to 0 ft., Dia in. to 0 ft.  
 Casing height above land surface 12 in., weight 200 lbs/ft. Wall thickness or gauge No. 17  
 TYPE OF SCREEN OR PERFORATION MATERIAL: PVC  
 SCREEN OR PERFORATION OPENINGS ARE: SAW CUT

SCREEN PERFORATED INTERVALS: From 490 ft. to 570 ft., From 0 ft. to 0 ft.  
 From 0 ft. to 0 ft., From 0 ft. to 0 ft.  
 GRAVEL PACK INTERVALS: From 25 ft. to 395 ft., From 0 ft. to 0 ft.  
 From 405 ft. to 575 ft., From 0 ft. to 0 ft.

6 GROUT MATERIAL BENTONITE  
 Grout Intervals: From 5 ft. to 25 ft., From 395 ft. to 405 ft., From 0 ft. to 0 ft.  
 What is the nearest source of possible contamination: ABANDONED WELL  
 Direction from well? NORTHEAST How many feet? 15

FROM	TO	LITHOLOGIC LOG	FROM	TO	PLUGGING INTERVALS
0	20	01 TOPSOIL 05 CLAY 02 FINE SAND			
20	40	14 WHITE CLAY 35 CALACHIE 32 TAN CLAY			
40	60	32 TAN CLAY 36 BLUE CLAY 16 GRAY CLAY			
60	180	36 BLUE CLAY 24 THINROCLAYER			
180	200	07 BLUE SHALE			
200	260	36 BLUE CLAY 31 SHALE 24 THINROCLAYER			
260	280	16 GRAY CLAY 28 SAND 08 ROCK LAYERS			
280	310	29 SANDSTONE			
310	315	16 GRAY CLAY			
315	320	16 GRAY CLAY 29 SANDSTONE			

7 CONTRACTOR'S OR LANDOWNER'S CERTIFICATION: This water well was Constructed under my jurisdiction and was completed on (mo/day/year) 09/13/05 and this record is true to the best of my knowledge and belief. Kansas Water Well Contractor's License No. 179 This Water Well Record was completed on (mo/day/yr) 10/25/05 under the business name of JOB'S WELL SERVICE, INC. by (signature) *Judith Crick*

(Continued)

WATER WELL RECORD Form WWC-5 KSA 82a-1212

1 LOCATION OF WATER WELL:      Fraction      Section Number      Township Number      Range Number  
COUNTY: HODGEMAN      NE 1/4 NE 1/4 NE 1/4      32      T 22 S      R 24 W

2 WATER WELL OWNER:      BLOTE, LOIS  
RR#, St. Address, Box #:      108 S. TAYLOR      Board of Agriculture, Division of Water Resources  
City, State, ZIP code      : PRATT, KS      67124-      Application Number:      |

FROM	TO	LITHOLOGIC LOG
320	340	16 GRAY CLAY 26 RED CLAY 29 SANDSTONE
340	360	29 SANDSTONE 16 GRAY CLAY 26 RED CLAY
360	400	16 GRAY CLAY 26 RED CLAY 29 SANDSTONE
400	460	26 RED CLAY 36 BLUE CLAY
460	580	29 SANDSTONE
580	600	29 SANDSTONE 16 GRAY CLAY 26 RED CLAY

7 CONTRACTOR'S OR LANDOWNER'S CERTIFICATION: This water well was Constructed under my jurisdiction and was completed on (mo/day/year) 09/13/05 and this record is true to the best of my knowledge and belief. Kansas Water Well Contractor's License No. 179      This Water Well Record was completed on (mo/day/yr) 10/25/05 under the business name of JOB'S WELL SERVICE, INC.      by (signature) *Josid Crist*