

# HORSE THIEF CANYON NF

T R EW sec 1/4 1/4 1/4 No.

USE TYPEWRITER OR BALL POINT PEN-PRESS FIRMLY, PRINT CLEARLY.

WATER WELL RECORD  
KSA 82a-1201-1215

Kansas State Dept. Of Health  
(Water Well Contractors)  
Forbes-Bldg. 740  
Topeka, Kansas 66620

DAA


1 Location of well:	County <b>Hodgeman</b>	Township name <b>Hallet'</b>	Fraction <b>NE NESE</b>	Section number <b>12</b>	Town number <b>22</b>	Range number <b>25</b>
---------------------	---------------------------	---------------------------------	----------------------------	-----------------------------	--------------------------	---------------------------

Distance and direction from nearest town or city: **4 1/2 North**

Street address of well location if in city: **6 miles west**

3 Owner of well: **Wayne Shriwise**

Address:

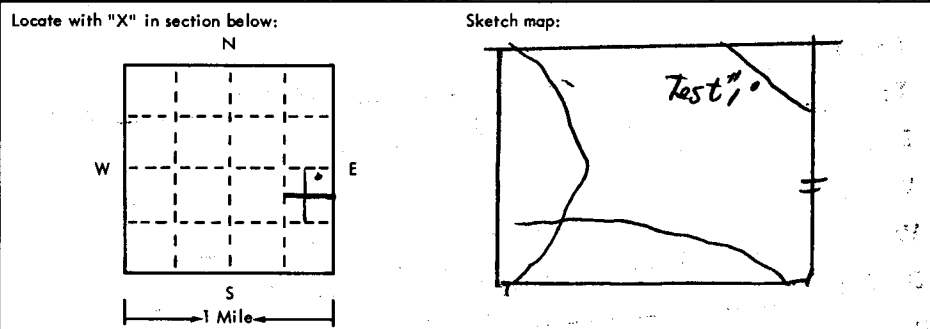

4 Well depth: **45** ft. Date of completion **11-20-75**  
Well diameter: **4 1/2** in.

5  Cable tool  Rotary  Driven  Dug  
 Hollow rod  Jetted  Bored  Reverse rotary

6 Use:  Domestic  Public supply  Industry  
 Irrigation  Air conditioning  Commercial  
 Test well

7 Casing: Material \_\_\_\_\_ Height: above/below \_\_\_\_\_  
Threaded  Welded  Surface \_\_\_\_\_ in.  
Diam. \_\_\_\_\_ Weight \_\_\_\_\_ lbs./ft. \_\_\_\_\_  
\_\_\_\_\_ in. to \_\_\_\_\_ ft. depth Drive shoe?  Yes  No  
\_\_\_\_\_ in. to \_\_\_\_\_ ft. depth

2 Type and color of material	From	To
<b>Black loam</b>	<b>0</b>	<b>8</b>
<b>Sand + Gravel</b>	<b>8</b>	<b>18</b>
<b>Sandy Clay</b>	<b>18</b>	<b>26</b>
<b>yellow clay</b>	<b>(26)</b>	<b>42</b>
<b>Blue clay</b>	<b>42</b>	<b>45</b>
<b>Shale</b>	<b>45</b>	
<b>BROCK 26'?</b>		
<b>0 sat. thick</b>		
<b>in Alluvium</b>		

8 Screen:  
Manufacturer \_\_\_\_\_  
Type \_\_\_\_\_ Dia. \_\_\_\_\_  
Slot/gauze \_\_\_\_\_ Length \_\_\_\_\_  
Set between \_\_\_\_\_ ft. and \_\_\_\_\_ ft. \_\_\_\_\_  
Fittings:  
Gravel pack  Yes  No Size range of material \_\_\_\_\_

9 Static water level:  
\_\_\_\_\_ ft. below land surface Date \_\_\_\_\_

10 Pumping level below land surfaces:  
\_\_\_\_\_ ft. after \_\_\_\_\_ hrs. pumping \_\_\_\_\_ g.p.m.  
\_\_\_\_\_ ft. after \_\_\_\_\_ hrs. pumping \_\_\_\_\_ g.p.m.  
Estimated maximum yield **dry** g.p.m.

11 Water sample submitted:  
 Yes  No Date \_\_\_\_\_

12 Well head completion:  
 Pitless adapter  Inches above grade

13 Well grouted?  Yes  No  
 Neat cement  Bentonite  \_\_\_\_\_  
Depth: From \_\_\_\_\_ ft. to \_\_\_\_\_ ft.

14 Nearest source of possible contamination:  
ft. \_\_\_\_\_ Direction \_\_\_\_\_ Type **None**  
Well disinfected upon completion?  Yes  No

15 Pump:  Not installed  
Manufacturer's name \_\_\_\_\_  
Model number \_\_\_\_\_ HP \_\_\_\_\_ Volts \_\_\_\_\_  
Length of drop pipe \_\_\_\_\_ ft. capacity \_\_\_\_\_ g.m.p.  
Type:  
 Submersible  Turbine  
 Jet  Reciprocating  
 Centrifugal  Other

16 Remarks: elevation

**Dry Hole**

2444  
28  
2418

Topography:  
 Hill  
 Slope  
 Upland  
 Valley **TOPO**

17 Water well contractor's certification:  
This well was drilled under my jurisdiction and this report is true to the best of my knowledge and belief.  
**Robert Halling Drill Well Service**  
Business name \_\_\_\_\_ License No. \_\_\_\_\_  
Address **Hanston Kansas 233A**  
Signed **Robert Halling** Date **11-20-75**  
Authorized representative

22 25W 12 NE NESE