


WATER WELL RECORD Form WWC-5 KSA 82a-1212

1 LOCATION OF WATER WELL: Fraction Section Number Township Number Range Number  
 COUNTY: HODGEMAN SE 1/4 SE 1/4 NE 1/4 8 T 22 S R 25 W

2 Distance and direction from nearest town or city street address of well if located within city?  
 FROM JETHORE ON 156 HIGHWAY - 10 1/2 MILBS WEST & 5 1/2 NORT

3 WATER WELL OWNER: SORBM, RICHARD  
 RR#, St. Address, Box #: RR #1 -- BOX 92 Board of Agriculture, Division of Water Resources  
 City, State, ZIP code: JETHORE, KS 67856- Application Number:

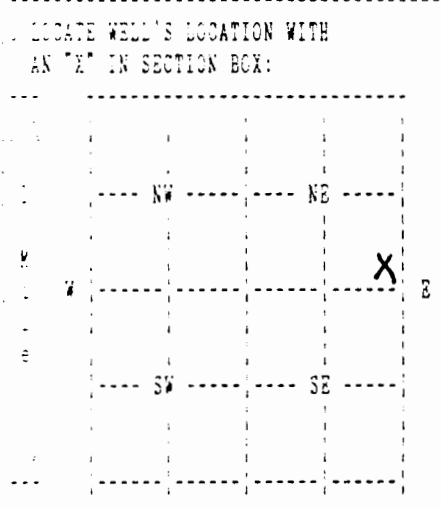

4 DEPTH OF COMPLETED WELL 546 ELEVATION: 0  
 Depth(s) Groundwater Encountered 1. 0 ft. 2. 0 ft. 3. 0 ft.  
 WELL'S STATIC WATER LEVEL 284 ft. below land surface measured on mo/day/yr 05/14/03  
 Pump testdata: Well water was 0 ft. after 0 hours pumping 0 gpm  
 Estimated Yield 40 gpm: Well water was 0 ft. after 0 hours pumping 0 gpm  
 Bore Hole Diameter 10 in. to 546 ft., and in. to 0 ft.  
 WELL WATER TO BE USED AS: DOMESTIC  
 Was a chemical/bacteriological sample submitted to department? No ;  
 If yes, mo/day/yr sample was submitted Water well disinfected? Yes

5 TYPE OF BLANK CASING USED: CERTA LOC CASIN CASING JOINTS: CERTA-LOC  
 Blank casing diameter 5 in. to 546 ft., Dia in. to 0 ft., Dia in. to 0 ft.  
 Casing height above land surface 12 in., weight 200 lbs/ft. Wall thickness or gauge No. 17  
 TYPE OF SCREEN OR PERFORATION MATERIAL:  
 SCREEN OR PERFORATION OPENINGS ARE: SAW CUT

SCREEN PERFORATED INTERVALS: From 400 ft. to 460 ft., From 0 ft. to 0 ft.  
 From 0 ft. to 0 ft., From 0 ft. to 0 ft.  
 GRAVEL PACK INTERVALS: From 25 ft. to 175 ft., From 0 ft. to 0 ft.  
 From 200 ft. to 546 ft., From 0 ft. to 0 ft.

6 GROUT MATERIAL BENTONITE  
 Grout Intervals: From 6 ft. to 25 ft., From 175 ft. to 200 ft., From 0 ft. to 0 ft.  
 What is the nearest source of possible contamination: NONE  
 Direction from well? How many feet? 0

FROM	TO	LITHOLOGIC LOG	FROM	TO	PLUGGING INTERVALS
0	20	01 TOPSOIL 05 CLAY			
20	80	05 CLAY 37 FIN-COAR SAN 06 SMALL GRAVEL			
80	120	32 TAN CLAY			
120	280	07 BLUE SHALE			
280	340	07 BLUE SHALE 29 SANDSTONE			
340	620	29 SANDSTONE			

7 CONTRACTOR'S OR LANDOWNER'S CERTIFICATION: This water well was Constructed under my jurisdiction and was completed on (mo/day/year) 06/23/03 and this record is true to the best of my knowledge and belief. Kansas Water Well Contractor's License No. 179 This Water Well Record was completed on (mo/day/yr) 06/27/03  
 under the business name of JOB'S WELL SERVICE, INC. by (signature) *Josiah Cuck*