

**WATER WELL RECORD Form WWC-5**


Division of Water  
Resources App. No.  

Well ID  

Original Record  Correction  Change in Well Use

<b>1 LOCATION OF WATER WELL:</b> County: Hodgeman		Fraction NW ¼ NE ¼ SE ¼ NW ¼	Section Number 23	Township Number T 22 S	Range Number R 26 <input type="checkbox"/> E <input checked="" type="checkbox"/> W
--	--	---------------------------------	----------------------	---------------------------	---

<b>2 WELL OWNER:</b> Last Name: Glunt First: Bob		Street or Rural Address where well is located (if unknown, distance and direction from nearest town or intersection): If at owner's address, check here: <input type="checkbox"/>
Business: Address: 11757 Belmont Drive Address: City: Ault State: CO ZIP: 8610		P Road & 205 Road, 1/2 mile West, 1/4 mile South

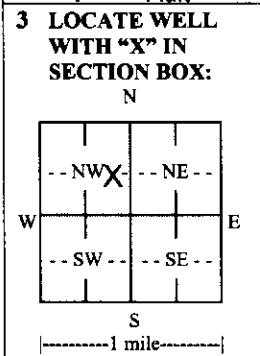

**4 DEPTH OF COMPLETED WELL:** ...420... ft.  
 Depth(s) Groundwater Encountered: 1) ...280... ft.  
 2) ..... ft. 3) ..... ft., or 4)  Dry Well  
 WELL'S STATIC WATER LEVEL: ..... 273 ..... ft.  
 below land surface, measured on (mo-day-yr) 10/06/2016  
 above land surface, measured on (mo-day-yr) .....  
 Pump test data: Well water was ..... ft.  
 after ..... hours pumping ..... gpm  
 Well water was ..... ft.  
 after ..... hours pumping ..... gpm  
 Estimated Yield: ..... 25 ..... gpm  
 Bore Hole Diameter: ..... 9 ..... in. to ..... 420 ..... ft. and  
 ..... in. to ..... ft.

**5 Latitude:** ..... 38.127106 ..... (decimal degrees)  
**Longitude:** ..... 100.145639 ..... (decimal degrees)  
 Datum:  WGS 84  NAD 83  NAD 27  
**Source for Latitude/Longitude:**  
 GPS (unit make/model: .....)  
 (WAAS enabled?  Yes  No)  
 Land Survey  Topographic Map  
 Online Mapper: .....  
**6 Elevation:** ..... 2530 ..... ft.  Ground Level  TOC  
**Source:**  Land Survey  GPS  Topographic Map  
 Other KOLAR .....

**7 WELL WATER TO BE USED AS:**

1. Domestic: <input type="checkbox"/> Household <input type="checkbox"/> Lawn & Garden <input checked="" type="checkbox"/> Livestock	2. <input type="checkbox"/> Irrigation	3. <input type="checkbox"/> Feedlot	4. <input type="checkbox"/> Industrial	5. <input type="checkbox"/> Public Water Supply: well ID .....	6. <input type="checkbox"/> Dewatering: how many wells? .....	7. <input type="checkbox"/> Aquifer Recharge: well ID .....	8. <input type="checkbox"/> Monitoring: well ID .....	9. Environmental Remediation: well ID .....	10. <input type="checkbox"/> Oil Field Water Supply: lease .....	11. Test Hole: well ID .....	12. Geothermal: how many bores? .....	13. <input type="checkbox"/> Other (specify): .....
---	--	-------------------------------------	--	--	---	---	---	---	--	------------------------------	---------------------------------------	---

**Was a chemical/bacteriological sample submitted to KDHE?**  Yes  No If yes, date sample was submitted: .....  
 Water well disinfected?  Yes  No

**8 TYPE OF CASING USED:**  Steel  PVC  Other ..... CASING JOINTS:  Glued  Clamped  Welded  Threaded  
 Casing diameter ..... 5 ..... in. to ..... 420 ..... ft., Diameter ..... in. to ..... ft., Diameter ..... in. to ..... ft.  
 Casing height above land surface ..... 18 ..... in. Weight ..... lbs./ft. Wall thickness or gauge No. SDR 17 .....

**TYPE OF SCREEN OR PERFORATION MATERIAL:**  
 Steel  Stainless Steel  Fiberglass  PVC  Other (Specify) .....  
 Brass  Galvanized Steel  Concrete tile  None used (open hole)  
**SCREEN OR PERFORATION OPENINGS ARE:**  
 Continuous Slot  Mill Slot  Gauze Wrapped  Torch Cut  Drilled Holes  Other (Specify) .....  
 Louvered Shutter  Key Punched  Wire Wrapped  Saw Cut  None (Open Hole)  
**SCREEN-PERFORATED INTERVALS:** From ..... 300 ..... ft. to ..... 420 ..... ft., From ..... ft. to ..... ft., From ..... ft. to ..... ft.  
**GRAVEL PACK INTERVALS:** From ..... 0 ..... ft. to ..... 5 ..... ft., From ..... 30 ..... ft. to ..... 420 ..... ft., From ..... ft. to ..... ft.

**9 GROUT MATERIAL:**  Neat cement  Cement grout  Bentonite  Other .....  
 Grout Intervals: From ..... 5 ..... ft. to ..... 30 ..... ft., From ..... ft. to ..... ft., From ..... ft. to ..... ft.

**Nearest source of possible contamination:**  
 Septic Tank  Lateral Lines  Pit Privy  Livestock Pens  Insecticide Storage  
 Sewer Lines  Cess Pool  Sewage Lagoon  Fuel Storage  Abandoned Water Well  
 Watertight Sewer Lines  Seepage Pit  Feedyard  Fertilizer Storage  Oil Well/Gas Well  
 Other (Specify) .....

Direction from well? N/A ..... Distance from well? ..... ft.

10 FROM	TO	LITHOLOGIC LOG	FROM	TO	LITHO. LOG (cont.) or PLUGGING INTERVALS
Attached	Attached	Attached			

**11 CONTRACTOR'S OR LANDOWNER'S CERTIFICATION:** This water well was  constructed,  reconstructed, or  plugged under my jurisdiction and was completed on (mo-day-year) 10/06/2016 ..... and this record is true to the best of my knowledge and belief. Kansas Water Well Contractor's License No. 846 ..... This Water Well Record was completed on (mo-day-year) 10/18/2016 ..... under the business name of Nash Water Well Service, LLC .....

Form	WWC5
Contractor	Nash Water Well Service, LLC
Well Owner	Bob Glunt
Doc ID	1319919

Litholgy

0	17	Top soil. Tan clay.
17	26	Fine coarse sand w/small to large gravel.
26	27	Rock
27	45	Fine coarse sand. Rock layers.
45	70	Tan clay.
70	130	Blue shale.
130	150	Limestone. Blue shale.
160	190	Gray sand streak layers. Hard rock layers.
		Blue shale.
190	230	Blue clay.
230	260	Blue shale.
260	280	Gray clay & gray sand stone streaks.
280	300	Gray sand stone.
300	320	Gray clay w/gray sand stone streaks.
320	412	Gray sand stone w/ gray clay layers.
412	420	Blue shale.