


WATER WELL RECORD Form WWC-5 KSA 82a-1212

1 LOCATION OF WATER WELL: Fraction Section Number Township Number Range Number  
 COUNTY: FINNEY NE 1/4 NE 1/4 SW 1/4 14 T 22 S R 27 W

Distance and direction from nearest town or city street address of well if located within city?  
 FROM KALVESTA - 1 EAST, 5 1/2 NORTH & 1/2 EAST

2 WATER WELL OWNER: FINNUP LAND CO.  
 RR#, St. Address, Box #: PO BOX 795 -- 119 W. MAIN Board of Agriculture, Division of Water Resources  
 City, State, ZIP code: GARDEN CITY, KS 67846- Application Number:

3 LOCATE WELL'S LOCATION WITH AN "X" IN SECTION BOX:

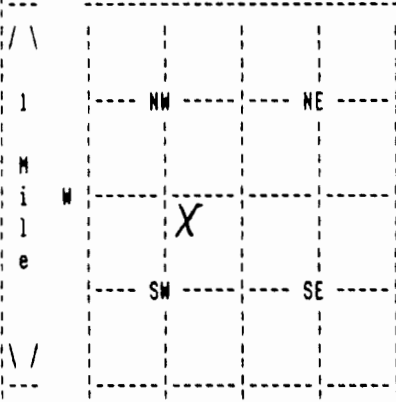

4 DEPTH OF COMPLETED WELL 56 ELEVATION: 0  
 Depth(s) Groundwater Encountered 1. 0 ft. 2. 0 ft. 3. 0 ft.

WELL'S STATIC WATER LEVEL 18 ft. below land surface measured on mo/day/yr 12/21/09  
 Pump test data: Well water was 0 ft. after 0 hours pumping 0 gpm

Estimated Yield 25 gpm: Well water was 0 ft. after 0 hours pumping 0 gpm

Bore Hole Diameter 10 in. to 56 ft., and in. to 0 ft.

WELL WATER TO BE USED AS: DOMESTIC

Was a chemical/bacteriological sample submitted to department? No ;  
 If yes, mo/day/yr sample was submitted Water well disinfected? Yes

5 TYPE OF BLANK CASING USED: CERTA LOC CASIM CASING JOINTS: CERTA-LOC  
 Blank casing diameter 5 in. to 56 ft., Dia in. to 0 ft., Dia in. to 0 ft.  
 Casing height above land surface 12 in., weight 200 lbs/ft. Wall thickness or gauge No. 21  
 TYPE OF SCREEN OR PERFORATION MATERIAL: PVC  
 SCREEN OR PERFORATION OPENINGS ARE: SAW CUT

SCREEN PERFORATED INTERVALS: From 18 ft. to 38 ft., From 0 ft. to 0 ft.  
 From 0 ft. to 0 ft., From 0 ft. to 0 ft.  
 GRAVEL PACK INTERVALS: From 18 ft. to 56 ft., From 0 ft. to 0 ft.  
 From 0 ft. to 0 ft., From 0 ft. to 0 ft.

6 GROUT MATERIAL BENTONITE  
 Grout Intervals: From 0 ft. to 18 ft., From 0 ft. to 0 ft., From 0 ft. to 0 ft.  
 What is the nearest source of possible contamination: NONE - NEW SITE  
 Direction from well? How many feet? 0

FROM	TO	LITHOLOGIC LOG	FROM	TO	PLUGGING INTERVALS
0	20	01 TOPSOIL 05 CLAY 02 FINE SAND			
20	38	37 FIN-COAR SAN 27 ROCK 09 GRAVEL			
38	60	07 BLUE SHALE			

7 CONTRACTOR'S OR LANDOWNER'S CERTIFICATION: This water well was Constructed under my jurisdiction and was completed on (mo/day/year) 12/21/09 and this record is true to the best of my knowledge and belief. Kansas Water Well Contractor's License No. 179 This Water Well Record was completed on (mo/day/yr) 02/20/10 under the business name of JOE'S WELL SERVICE, INC. by (signature) *Joe's Well Service*