


WATER WELL RECORD Form WWC-5 KSA 82a-1212

1 LOCATION OF WATER WELL: Fraction Section Number Township Number Range Number
 COUNTY: FINNEY SW 1/4 SW 1/4 SE 1/4 23 T 22 S R 27 W

Distance and direction from nearest town or city street address of well if located within city?
 N38° 07' 052" W100° 14.119

2 WATER WELL OWNER: FINNUP LAND COMPANY
 RR#, St. Address, Box #: 119 N. MAIN -- BOX 795 Board of Agriculture, Division of Water Resources
 City, State, ZIP code: GARDEN CITY, KS 67846- Application Number:

3 LOCATE WELL'S LOCATION WITH AN "X" IN SECTION BOX:

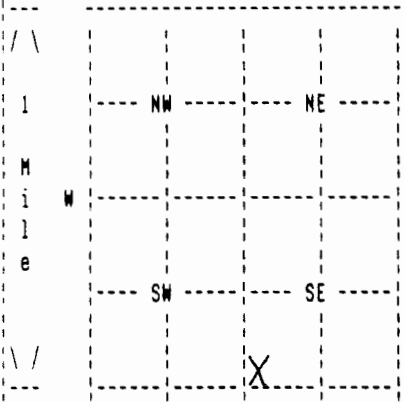

4 DEPTH OF COMPLETED WELL 605 ELEVATION: 2582
 Depth(s) Groundwater Encountered 1. 0 ft. 2. 0 ft. 3. 0 ft.

WELL'S STATIC WATER LEVEL 310 ft. below land surface measured on mo/day/yr 11/11/09
 Pump test data: Well water was 0 ft. after 0 hours pumping 0 gpm

Estimated Yield 30 gpm: Well water was 0 ft. after 0 hours pumping 0 gpm

Bore Hole Diameter 10 in. to 605 ft., and in. to 0 ft.

WELL WATER TO BE USED AS: DOMESTIC

Was a chemical/bacteriological sample submitted to department? No;
 If yes, mo/day/yr sample was submitted Water well disinfected? Yes

5 TYPE OF BLANK CASING USED: CERTA LOC CASIM CASING JOINTS: CERTA-LOC
 Blank casing diameter 5 in. to 605 ft., Dia in. to 0 ft., Dia in. to 0 ft.
 Casing height above land surface 12 in., weight 200 lbs/ft. Wall thickness or gauge No. 17 80
 TYPE OF SCREEN OR PERFORATION MATERIAL: PVC
 SCREEN OR PERFORATION OPENINGS ARE: SAW CUT

SCREEN PERFORATED INTERVALS: From 240 ft. to 600 ft., From 0 ft. to 0 ft.
 From 0 ft. to 0 ft., From 0 ft. to 0 ft.
 GRAVEL PACK INTERVALS: From 30 ft. to 120 ft., From 0 ft. to 0 ft.
 From 130 ft. to 605 ft., From 0 ft. to 0 ft.

6 GROUT MATERIAL BENTONITE
 Grout Intervals: From 6 ft. to 30 ft., From 120 ft. to 130 ft., From 0 ft. to 0 ft.
 What is the nearest source of possible contamination: NONE - NEW SITE
 Direction from well? How many feet? 0

FROM	TO	LITHOLOGIC LOG	FROM	TO	PLUGGING INTERVALS
0	20	01 TOPSOIL 32 TAN CLAY 10 FINE-MEDSAND			
20	40	37 FIN-COAR SAN			
40	60	37 FIN-COAR SAN 06 SMALL GRAVEL 05 CLAY			
60	80	05 CLAY			
80	100	05 CLAY 37 FIN-COAR SAN 05 CLAY			
100	120	05 CLAY 07 BLUE SHALE			
120	280	07 BLUE SHALE			
280	340	36 BLUE CLAY			
340	350	36 BLUE CLAY 16 GRAY CLAY			
350	610	29 SANDSTONE			

Original Returned to Sender
 for Correction Date: 5/7/10

7 CONTRACTOR'S OR LANDOWNER'S CERTIFICATION: This water well was Constructed under my jurisdiction and was completed on (mo/day/year) 01/27/10 and this record is true to the best of my knowledge and belief. Kansas Water Well Contractor's License No. 179 This Water Well Record was completed on (mo/day/yr) 02/23/10 under the business name of JOE'S WELL SERVICE, INC. by (signature) Judith Crick