

1 LOCATION OF WATER WELL:	Fraction	Section Number	Township Number	Range Number
County: HARVEY	SE 1/4 SE 1/4 SE 1/4	19	22 SOUTH	3 WEST


Distance and direction from nearest town or city street address of well if located within city?

FROM BUHLER, KS: 5 MILES EAST AND 2 MILES SOUTH

2 WATER WELL OWNER: ROBERT FRIESEN

RR#, St. Address, Box #: 23001 NW 60TH
City, State, ZIP Code : BUHLER, KS 67522Board of Agriculture, Division of Water Resources
Application Number: NA3 MARK WELL'S LOCATION WITH
AN "X" IN SECTION BOX:

N

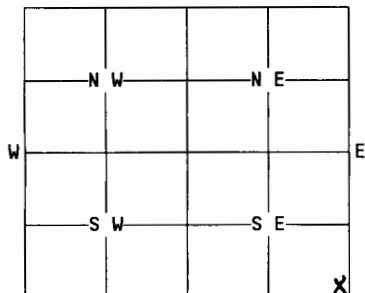

S

4 DEPTH OF WELL.....97.....ft.

WELL'S STATIC WATER LEVEL.....25.28.....ft.

WELL WAS USED AS:

- | | | |
|--------------|--------------------------|--------------------|
| 1 Domestic | 5 Public Water Supply | 9 Dewatering |
| 2 Irrigation | 6 Oil Field Water Supply | 10 Monitoring Well |
| 3 Feedlot | 7 Lawn and Garden Only | 11 Injection Well |
| 4 Industrial | 8 Air Conditioning | 12 Other..... |

Was a chemical/bacteriological sample submitted to Department? Yes....No X..
If yes, mo/day/yr sample was submitted.....Water Well Disinfected: Yes...X... No.....

5 TYPE OF BLANK CASING USED:

- | | | | | |
|---------|------------|-------------------|-----------------|-------------------------|
| 1 Steel | 3 RMP (SR) | 5 Wrought | 7 Fiberglass | 9 Other (specify below) |
| 2 PVC | 4 ABS | 6 Asbestos-Cement | 8 Concrete Tile | |

Blank casing diameter.....6.....in. Was casing pulled? Yes..... No...X... If yes, how much.....
Casing height above/below land surface.....36.....in.6 GROUT PLUG MATERIAL: 1 Neat cement 2 Cement grout 3 Bentonite 4 Other.....Grout Plug Intervals: From 24 ft. to 3 ft., From.....ft. toft., From..... toft.

What is the nearest source of possible contamination:

- | | | | |
|--------------------------|-------------------|-------------------------|--------------------------|
| 1 Septic tank | 6 Seepage pit | 11 Fuel storage | 16 Other (specify below) |
| 2 Sewer lines | 7 Pit privy | 12 Fertilizer storage | |
| 3 Watertight sewer lines | 8 Sewage lagoon | 13 Insecticide storage | |
| 4 Lateral lines | 9 Feedyard | 14 Abandoned water well | |
| 5 Cess Pool | 10 Livestock pens | 15 Oil well/Gas well | <u>Tank Battery</u> |

Direction from well? North..... How many feet? Approx 300

FROM	TO	PLUGGING MATERIALS
97	24	CLEAN SAND
<u>24</u>	<u>3</u>	<u>Cement grout</u>
<u>3</u>	<u>0</u>	<u>Top soil</u>

7 CONTRACTOR'S OR LANDOWNER'S CERTIFICATION: This water well was plugged under my jurisdiction and was completed on (mo/day/year) 2-8-96 and this record is true to the best of my knowledge and belief. Kansas Water Well Contractor's License No. NA This Water Well Record was completed on (mo/day/year) 2-19-96 under the business name of NA by (signature) Robert L. Friesen

INSTRUCTIONS: Use typewriter or ball point pen. Please press firmly and print clearly. Please fill in blanks, underline or circle the correct answers. Send top three copies to Kansas Department of Health and Environment, Bureau of Water, Topeka, Kansas 66620-0001. Telephone: 913/296-3565. Send one to Water Well Owner and retain one for your records.