

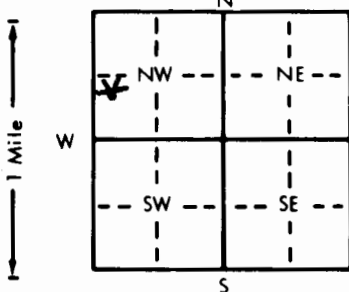
1 LOCATION OF WATER WELL:	Fraction	Section Number	Township Number	Range Number
County: <u>HARVEY</u>	<u>NW 1/4 SW 1/4 NW 1/4</u>	<u>15</u>	T <u>22</u> S	R <u>3</u> <u>EW</u>

Distance and direction from nearest town or city street address of well if located within city?

11 miles West of Hesston

2 WATER WELL OWNER:	RR#, St. Address, Box #	City, State, ZIP Code	Board of Agriculture, Division of Water Resources
<u>STEVE RATZLAFF</u>	<u>RR #1</u>	<u>Buhler, KS 67522</u>	Application Number:

3 LOCATE WELL'S LOCATION WITH AN "X" IN SECTION BOX:	4 DEPTH OF COMPLETED WELL	ELEVATION:
--	---------------------------	------------


WELL WATER TO BE USED AS: 5 Public water supply 8 Air conditioning 11 Injection well

1 Domestic 3 Feedlot 6 Oil field water supply 9 Dewatering 12 Other (Specify below)

2 Irrigation 4 Industrial 7 Lawn and garden only 10 Observation well

Was a chemical/bacteriological sample submitted to Department? Yes X No X; If yes, mo/day/yr sample was submittedWater Well Disinfected? Yes No

5 TYPE OF BLANK CASING USED:	5 Wrought iron	8 Concrete tile	CASING JOINTS: Glued <u>X</u> Clamped
1 Steel	3 RMP (SR)	6 Asbestos-Cement	9 Other (specify below)
2 PVC	4 ABS	7 Fiberglass	10 Asbestos-cement


TYPE OF SCREEN OR PERFORATION MATERIAL:	1 Steel	3 Stainless steel	5 Fiberglass	8 RMP (SR)	11 Other (specify)
2 Brass	4 Galvanized steel	6 Concrete tile	9 ABS	12 None used (open hole)	

SCREEN OR PERFORATION OPENINGS ARE: 5 Gauzed wrapped 1025 8 Saw cut factory 11 None (open hole)

1 Continuous slot 3 Mill slot 6 Wire wrapped 9 Drilled holes

2 Louvered shutter 4 Key punched 7 Torch cut 10 Other (specify)


6 GROUT MATERIAL:	1 Neat cement	2 Cement grout	3 Bentonite	4 Other
-------------------	---------------	----------------	-------------	---------


What is the nearest source of possible contamination: 10 Livestock pens 14 Abandoned water well

1 Septic tank 4 Lateral lines 7 Pit privy 11 Fuel storage 15 Oil well/Gas well

2 Sewer lines 5 Cess pool 8 Sewage lagoon 12 Fertilizer storage 16 Other (specify below)

3 Watertight sewer lines 6 Seepage pit 9 Feedyard 13 Insecticide storage

Direction from well? N North East How many feet? 60'

FROM TO LITHOLOGIC LOG FROM TO LITHOLOGIC LOG

FROM TO LITHOLOGIC LOG FROM TO LITHOLOGIC LOG

