

1 LOCATION OF WATER WELL:	Fraction	Section Number	Township Number	Range Number
County: <u>Harvey</u>	<u>NE 1/4 SW 1/4 NE 1/4</u>	<u>5</u>	T <u>22</u> S	R <u>3</u> E <u>(W)</u>


Distance and direction from nearest town or city street address of well if located within city?

6 mi. E, 1 3/4 N of Buhler

2 WATER WELL OWNER:	Board of Agriculture, Division of Water Resources
RR#, St. Address, Box # :	Application Number:
City, State, ZIP Code :	

Arlo SchmidtRt 1Moundridge, KS 67107

3 LOCATE WELL'S LOCATION WITH AN "X" IN SECTION BOX:	4 DEPTH OF COMPLETED WELL <u>108</u> ft. ELEVATION:
--	---

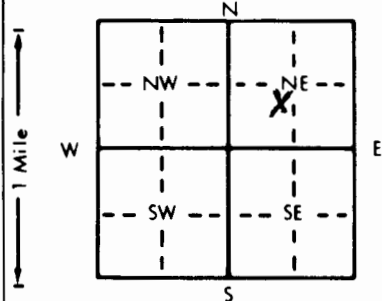

Depth(s) Groundwater Encountered 1. ft. 2. ft. 3. ft.

WELL'S STATIC WATER LEVEL 42 ft. below land surface measured on mo/day/yr 4-14-90Pump test data: Well water was 44 ft. after 1 hours pumping 25 gpmEst. Yield gpm: Well water was 44 ft. after 1 hours pumping 25 gpmBore Hole Diameter 9 in. to 114 ft., and 114 in. to 114 ft.

WELL WATER TO BE USED AS:

<input checked="" type="checkbox"/> Domestic	3 Feedlot	6 Oil field water supply	9 Dewatering	12 Other (Specify below)
2 Irrigation	4 Industrial	7 Lawn and garden only	10 Monitoring well	

Was a chemical/bacteriological sample submitted to Department? Yes X No X; If yes, mo/day/yr sample was sub-

mitted

Water Well Disinfected? Yes X No X

5 TYPE OF BLANK CASING USED:	5 Wrought iron	8 Concrete tile	CASING JOINTS: Glued <u>X</u> Clamped
------------------------------	----------------	-----------------	---------------------------------------

1 Steel 3 RMP (SR) 6 Asbestos-Cement 9 Other (specify below) Welded

☒ PVC 4 ABS 7 Fiberglass ThreadedBlank casing diameter 5 in. to 98 ft. Dia 5 in. to 98 ft. Dia 5 in. to 98 ft.Casing height above land surface 14 in., weight 14 lbs./ft. Wall thickness or gauge No. 160

TYPE OF SCREEN OR PERFORATION MATERIAL:

1 Steel 3 Stainless steel 5 Fiberglass 8 RMP (SR) 10 Asbestos-cement

2 Brass 4 Galvanized steel 6 Concrete tile 9 ABS 11 Other (specify)

SCREEN OR PERFORATION OPENINGS ARE:

1 Continuous slot 3 Mill slot 5 Gauzed wrapped ☒ 8 Saw cut 11 None (open hole)

2 Louvered shutter 4 Key punched 6 Wire wrapped 9 Drilled holes

SCREEN-PERFORATED INTERVALS: From 98 ft. to 108 ft. From 98 ft. to 108 ft.GRAVEL PACK INTERVALS: From 23 ft. to 75 ft. From 80 ft. to 114 ft.7 CONTRACTOR'S OR LANDOWNER'S CERTIFICATION: This water well was ☒ (1) constructed, (2) reconstructed, or (3) plugged under my jurisdiction and wascompleted on (mo/day/year) 4-24-90 and this record is true to the best of my knowledge and belief. KansasWater Well Contractor's License No. 447 This Water Well Record was completed on (mo/day/yr) 4-25-90under the business name of Miller Drilling by (signature) E. Miller