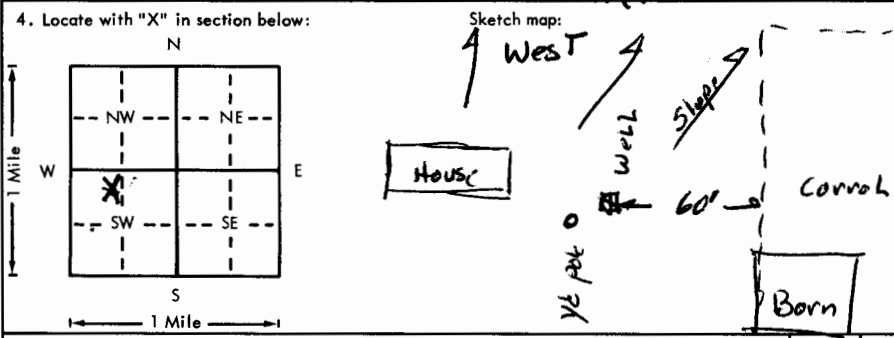


USE TYPEWRITER OR BALL
POINT PEN-PRESS FIRMLY,
PRINT CLEARLY.

WATER WELL RECORD
KSA 82a-1201-1215

Kansas Department of Health and
Environment-Division of Environment
(Water well Contractors)
Topeka, Kansas 66620

1. Location of well:		County HARVEY	Fraction NE 1/4 NW 1/4 SW 1/4	Section number 5	Township number T 22 S	Range number R 3 E
2. Distance and direction from nearest town or city: Street address of well location if in city:		3 1/2 EAST - 2 1/2 North - Butler		3. Owner of well: Herbert Uoth R.R. Inman City, state, zip code:		
4. Locate with "X" in section below: 				6. Bore hole dia. 12 in. Completion date 3/25/76 Well depth _____ ft.		
5. Type and color of material				7. <input type="checkbox"/> Cable tool <input checked="" type="checkbox"/> Rotary <input type="checkbox"/> Driven <input type="checkbox"/> Dug <input type="checkbox"/> Hollow rod <input type="checkbox"/> Jetted <input type="checkbox"/> Bored <input type="checkbox"/> Reverse rotary		
				8. Use: <input checked="" type="checkbox"/> Domestic <input type="checkbox"/> Public supply <input type="checkbox"/> Industry <input type="checkbox"/> Irrigation <input type="checkbox"/> Air conditioning <input type="checkbox"/> Stock <input type="checkbox"/> Lawn <input type="checkbox"/> Oil field water <input type="checkbox"/> Other		
				9. Casing: Material plastic Height: Above or below Threaded <input type="checkbox"/> Welded <input checked="" type="checkbox"/> Surface 12" in. RMP <input type="checkbox"/> PVC <input checked="" type="checkbox"/> Weight 3.23 lbs./ft. Dia. 6 in. to 11 1/2 ft. depth Wall Thickness: inches or Dia. _____ in. to _____ ft. depth Gage No. 255		
				10. Screen: Manufacturer's name Cert-tech own slot Type PVC Dia. 6" Slot/gauze .064 Length 20' Set between 93 ft. and 113 ft. Gravel pack? <input checked="" type="checkbox"/> Size range of material 1/8-1/4		
				11. Static water level: _____ no./day/yr. 35 ft. below land surface Date 3/25/76		
				12. Pumping level below land surfaces: _____ ft. after _____ hrs. pumping _____ g.p.m. 43 ft. after 2 hrs. pumping 30 g.p.m. Estimated maximum yield 100 g.p.m.		
				13. Water sample submitted: _____ mo./day/yr. Yes <input checked="" type="checkbox"/> No <input type="checkbox"/> Date _____		
				14. Well head completion: <input checked="" type="checkbox"/> Pitless adapter _____ Inches above grade		
				15. Well grouted? <input checked="" type="checkbox"/> With: <input checked="" type="checkbox"/> Neat cement <input type="checkbox"/> Bentonite <input type="checkbox"/> Concrete Depth: From 10 ft. to 0 ft.		
				16. Nearest source of possible contamination: ft. 60' Direction North Type Corral Well disinfected upon completion? <input checked="" type="checkbox"/> Yes <input type="checkbox"/> No		
				17. Pump: _____ Not installed Manufacturer's name FEW (EXISTING) Model number _____ HP 1/2 Volts 230 Length of drop pipe 70 ft. capacity 14 g.p.m. Type: <input checked="" type="checkbox"/> Submersible <input type="checkbox"/> Turbine <input type="checkbox"/> Jet <input type="checkbox"/> Reciprocating <input type="checkbox"/> Centrifugal <input type="checkbox"/> Other		
(Use a second sheet if needed)						
18. Elevation:		19. Remarks: Replacement well - old well filled & sealed		20. Water well contractor's certification: This well was drilled under my jurisdiction and this report is true to the best of my knowledge and belief. PAUL'S INC #175 Business name License No. Address Box 26 Houghton Signed Paul Boudier Date 3/30/76 Authorized representative		