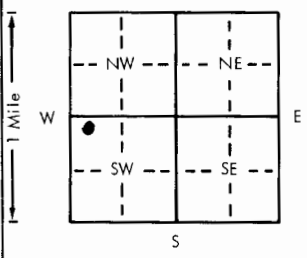
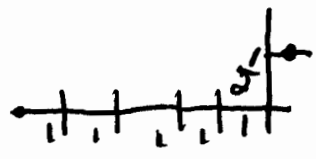


USE TYPEWRITER OR BALL
POINT PEN-PRESS FIRMLY,
PRINT CLEARLY.

WATER WELL RECORD
KSA 82a-1201-1215

Kansas Department of Health and
Environment-Division of Environment
(Water well Contractors)
Topeka, Kansas 66620

1. Location of well:		County Harney	Fraction NW 1/4 NW 1/4 SW 1/4	Section number 9	Township number T 22 S	Range number R 3 E/W
2. Distance and direction from nearest town or city: 5 miles 1/2 East of Buhler				3. Owner of well: Edwin Schmidt R.R. or street: R.R. 1 State, zip code: Moondridge, Kansas 67107		
4. Locate with "X" in section below:		Sketch map:		6. Bore hole dia. 2 1/2 in. Completion date 5/10/79 Well depth 214 ft.		
				7. Cable tool <input type="checkbox"/> Rotary <input type="checkbox"/> Driven <input type="checkbox"/> Dug <input type="checkbox"/> Hollow rod <input type="checkbox"/> Jetted <input type="checkbox"/> Bored <input checked="" type="checkbox"/> Reverse rotary		
5. Type and color of material				8. Use: Domestic <input type="checkbox"/> Public supply <input type="checkbox"/> Industry <input type="checkbox"/> <input checked="" type="checkbox"/> Irrigation <input type="checkbox"/> Air conditioning <input type="checkbox"/> Stock <input type="checkbox"/> Lawn <input type="checkbox"/> Oil field water <input type="checkbox"/> Other		
Top Soil 0 3 Clay				9. Casing: Material Transite Above or below Threaded <input type="checkbox"/> Welded <input type="checkbox"/> Surface <input checked="" type="checkbox"/> 12 in. RMP <input type="checkbox"/> PVC <input type="checkbox"/> Weight 30 lbs./ft. Dia. 16 in. to 16 1/2 ft. depth Wall Thickness: inches or Dia. 0 in. to 16 1/2 ft. depth gage No. 16		
Gray stky. clay 3 4 Clay w/ fine sand				10. Screen: Manufacturer's name Johnson Type Sawed Dia. 16 Slot/gauze 3/16 Length 32 Set between 16 1/2 ft. and 214 ft. ft. and 214 ft.		
Brown clay 4 9 Med. sand				Gravel pack? <input checked="" type="checkbox"/> Size range of material 1/8 x 1/4		
Hard brn. clay 9 12 Med. sand w/ clay				11. Static water level: 37 ft. below land surface Date 5-10-79		
Brown clay 12 38 Med. sand				12. Pumping level below land surfaces: 79 ft. after 1 hrs. pumping 900 g.p.m. 79 ft. after 2 hrs. pumping 1400 g.p.m. Estimated maximum yield 1500 g.p.m.		
Fine sand 38 45 Clay break				13. Water sample submitted: mo./day/yr. Yes <input type="checkbox"/> No <input checked="" type="checkbox"/> Date		
Fine sand 45 49 Med. sand				14. Well head completion: 8 inches above grade Pitless adapter <input type="checkbox"/>		
Med. sand 49 66 Clay				15. Well grouted? yes With: Neat cement <input type="checkbox"/> Bentonite <input checked="" type="checkbox"/> Concrete <input type="checkbox"/> Depth: From 0 ft. to 10 ft.		
w/clay drilled 66 75 Sandy streak				16. Nearest source of possible contamination: ft. 0 Direction none Type none Well disinfected upon completion? Yes <input type="checkbox"/> No <input checked="" type="checkbox"/>		
Med. sand, w/clay 75 90 Clay				17. Pump: <input type="checkbox"/> Not installed Manufacturer's name Western Land Roller Model number 2500-1200 60 Volts 1200 Length of drop pipe 80 ft. capacity 1200 g.p.m. Type: <input type="checkbox"/> Submersible <input checked="" type="checkbox"/> Turbine <input type="checkbox"/> Jet <input type="checkbox"/> Reciprocating <input type="checkbox"/> Centrifugal <input type="checkbox"/> Other		
breaks at 78' & 87' 75 90 Med. sand				20. Water well contractor's certification: This well was drilled under my jurisdiction and this report is true to the best of my knowledge and belief. Rosencrantz-Bemis Ent. Inc. 134 Business name 1211 W. 4th, Hutchinson, Kansas License No. 6-8-79 Address mile 70 Harney Date 6-8-79 Signed Authorized representative		
Med. sand 90 96 Clay w/very little sand						
Med. sand w/clay 96 105 Med. sand w/ clay						
Med. sand 105 113 Med. sand						
Clay, w/sand 113 120 Clay break						
(Use second sheet if needed)						
Med. sand 120 206						
Clay 206 209						
Med. sand 209 229						
Shale 229						
18. Elevation:		19. Remarks:				
Topography: <input type="checkbox"/> Hill <input checked="" type="checkbox"/> Slope <input type="checkbox"/> Upland <input type="checkbox"/> Valley						