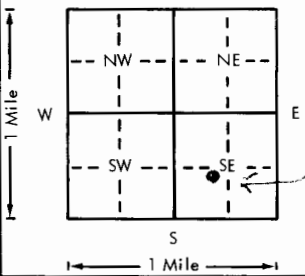


USE TYPEWRITER OR BALL
POINT PEN-PRESS FIRMLY,
PRINT CLEARLY.

WATER WELL RECORD
KSA 82a-1201-1215

Kansas Department of Health and
Environment-Division of Environment
(Water well Contractors)
Topeka, Kansas 66620

X Location of well:		County HARVEY	Fraction NE 1/4 SW 1/4 SE 1/4	Section number 11	Township number T 22 S R 3	Range number 3
X Distance and direction from nearest town or city: 2 1/2 mi SW		3. Owner of well: Clifford Schmidt		R.R. or street: R.R. #1		
Street address of well location if in city: BURTON, KS.		City, state, zip code: MCINABRIDGE, KS 67107				
4. Locate with "X" in section below:		Sketch map:		6. Bore hole dia. 3 1/2 in. Completion date 7-1-77		
				Well depth 101 ft.		
				7. Cable tool <input type="checkbox"/> Rotary <input type="checkbox"/> Driven <input type="checkbox"/> Dug <input type="checkbox"/> Hollow rod <input type="checkbox"/> Jetted <input type="checkbox"/> Bored <input checked="" type="checkbox"/> Reverse rotary		
				8. Use: Domestic <input type="checkbox"/> Public supply <input type="checkbox"/> Industry <input type="checkbox"/> <input checked="" type="checkbox"/> Irrigation <input type="checkbox"/> Air conditioning <input type="checkbox"/> Stock <input type="checkbox"/> Lawn <input type="checkbox"/> Oil field water <input type="checkbox"/> Other <input type="checkbox"/>		
				9. Casing: Material TRIPLEX Height: 92 ft. Above or below MC Threaded <input type="checkbox"/> Welded <input type="checkbox"/> Surface <input type="checkbox"/> Dia. 1 1/2 in. RMP <input type="checkbox"/> PVC <input type="checkbox"/> Weight 32 lbs./ft. Dia. 1 1/2 in. to 1 1/2 ft. depth Wall Thickness: inches or Dia. <input type="checkbox"/> in. to <input type="checkbox"/> ft. depth gage No. 75.1		
5. Type and color of material		From	To	10. Screen: Manufacturer's name ASSOCIATED TILE COMPANY		
Top Soil		0	3	Type TRANSITE Dia. 1 1/2 in.		
RED CLAY		3	13	Slot/gauze 1/4 in Length 39 ft		
BUFF CLAY		13	32	Set between 62 ft. and 101 ft.		
FINE SAND		32	50	Gravel pack? YES Size range of material 1/4 in		
MED. SAND		50	55	11. Static water level: 28 ft. below land surface Date 7-4-77		
GRAY CLAY		55	62	12. Pumping level below land surfaces: ft. after hrs. pumping g.p.m. ft. after hrs. pumping g.p.m. Estimated maximum yield 1000 g.p.m.		
GREEN SANDY CLAY		62	68	13. Water sample submitted: YES No <input checked="" type="checkbox"/> Date 7-4-77		
MED. COARSE SAND		68	99	14. Well head completion: Pitless adapter 12 inches above grade		
GREEN SHALE		99	101	15. Well grouted? YES PUCOLE CLAY With: Neat cement <input type="checkbox"/> Bentonite <input type="checkbox"/> Concrete <input type="checkbox"/> Depth: From 0 ft. to 12 ft.		
				16. Nearest source of possible contamination: ft. 2000 Direction SIN Type FEEDLOT Well disinfected upon completion? <input type="checkbox"/> Yes <input type="checkbox"/> No		
				17. Pump: Manufacturer's name WESTERN LAND ROVER Model number 9M HP 60 Volts 240 Length of drop pipe 80 ft. capacity 900 g.p.m. Type: <input type="checkbox"/> Submersible <input checked="" type="checkbox"/> Turbine <input type="checkbox"/> Jet <input type="checkbox"/> Reciprocating <input type="checkbox"/> Centrifugal <input type="checkbox"/> Other		
18. Elevation:		19. Remarks:		20. Water well contractor's certification: This well was drilled under my jurisdiction and this report is true to the best of my knowledge and belief. PIETERSON IRRIGATION 138 Business name PIETERSON IRRIGATION License No. 138 Address PO BOX 150 LINCOLN, KS Signed M. P. Pierson Date 7-25-77 Authorized representative		