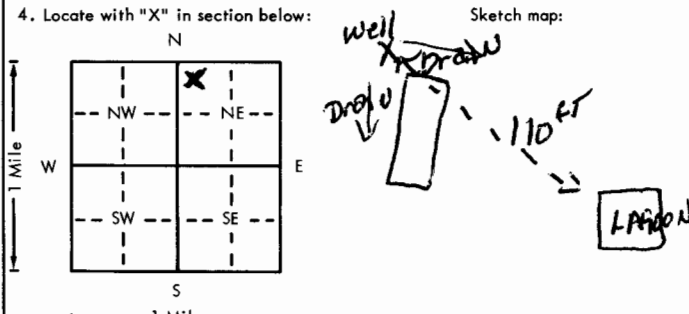


USE TYPEWRITER OR BALL  
POINT PEN-PRESS FIRMLY,  
PRINT CLEARLY.

WATER WELL RECORD  
KSA 82a-1201-1215

Kansas Department of Health and  
Environment-Division of Environment  
(Water well Contractors)  
Topeka, Kansas 66620

1. Location of well:		County <b>HARVEY</b>	Fraction <b>NW 1/4 NE-1/4</b>	Section number <b>12</b>	Township number <b>T 22 S</b>	Range number <b>R 2 E</b>
2. Distance and direction from nearest town or city: <b>4W, 3S, 5W of Moundridge KS</b>			3. Owner of well: <b>W. H. Albracht</b>			
Street address of well location if in city: <b>of Moundridge KS</b>			City, state, zip code: <b>Moundridge, Kansas.</b>			
4. Locate with "X" in section below: 			6. Bore hole dia. <b>8 1/2 in.</b> Completion date <b>10-1-77</b> Well depth <b>56</b> ft.			
5. Type and color of material			7. <input checked="" type="checkbox"/> Cable tool <input type="checkbox"/> Rotary <input type="checkbox"/> Driven <input type="checkbox"/> Dug <input type="checkbox"/> Hollow rod <input type="checkbox"/> Jetted <input type="checkbox"/> Bored <input type="checkbox"/> Reverse rotary			
			8. Use: <input checked="" type="checkbox"/> Domestic <input type="checkbox"/> Public supply <input type="checkbox"/> Industry <input type="checkbox"/> Irrigation <input type="checkbox"/> Air conditioning <input type="checkbox"/> Stock <input type="checkbox"/> Lawn <input type="checkbox"/> Oil field water <input type="checkbox"/> Other			
			9. Casing: Material <b>PLS</b> Height: Above or below Threaded <input type="checkbox"/> Welded <input type="checkbox"/> Surface <b>18</b> in. RMP <input type="checkbox"/> PVC <input checked="" type="checkbox"/> eight <input type="checkbox"/> lbs./ft. Dia. <b>5</b> in. to <b>56</b> ft. depth Wall Thickness: inches or Dia. <input type="checkbox"/> in. to <input type="checkbox"/> ft. depth gage No. <b>310</b>			
			10. Screen: Manufacturer's name <b>Burton Pump</b> Type <input type="checkbox"/> Dia. <input type="checkbox"/> Screen gauge <b>48</b> Length <input type="checkbox"/> Set between <input type="checkbox"/> ft. and <input type="checkbox"/> ft. Gravel pack? <b>Yes</b> Size range of material <b>10-40</b>			
			11. Static water level: <b>21</b> ft. below land surface Date <b>10-1-77</b>			
			12. Pumping level below land surfaces: <b>22</b> ft. after <b>1</b> hrs. pumping <b>20</b> g.p.m. <b>25</b> ft. after <b>6</b> hrs. pumping <b>20</b> g.p.m. Estimated maximum yield <b>?</b> g.p.m.			
			13. Water sample submitted: <input checked="" type="checkbox"/> Yes <input type="checkbox"/> No Date <input type="checkbox"/>			
			14. Well head completion: <input checked="" type="checkbox"/> Pitless adapter <input type="checkbox"/> Inches above grade <input checked="" type="checkbox"/> Well grouted? <b>Yes</b> With: <input checked="" type="checkbox"/> Neat cement <input type="checkbox"/> Bentonite <input type="checkbox"/> Concrete Depth: From <input type="checkbox"/> ft. to <input type="checkbox"/> ft.			
			17. Pump: Manufacturer's name <b>Her Motor</b> Model number <input type="checkbox"/> HP <b>3/4</b> Volts <b>220</b> Length of drop pipe <b>37</b> ft. capacity <b>20</b> g.p.m. Type: <input checked="" type="checkbox"/> Submersible <input type="checkbox"/> Turbine <input type="checkbox"/> Jet <input type="checkbox"/> Reciprocating <input type="checkbox"/> Centrifugal <input type="checkbox"/> Other			
18. Elevation:		19. Remarks: <b>Well has been tested by private lab &amp; proven to be OK.</b> <b>Dow E Kessler</b>		20. Water well contractor's certification: This well was drilled under my jurisdiction and this report is true to the best of my knowledge and belief. <b>Private</b> Business name <b>Dow E Kessler</b> License No. <b>None</b> Address <b>Dow E Kessler</b> Signed <b>Dow E Kessler</b> Date <input type="checkbox"/> Authorized representative		