

USE TYPEWRITER OR BALL  
POINT PEN-PRESS FIRMLY,  
PRINT CLEARLY.

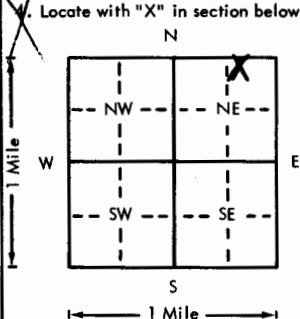
WATER WELL RECORD  
KSA 82a-1201-1215

Kansas Department of Health and  
Environment-Division of Environment  
(Water well Contractors)  
Topeka, Kansas 66620

Loc

1. Location of well: County Harvey Fraction NW 1/4 Me 1/4 Me 1/4 Section number 17 Township number 22 Range number 3 E

2. Distance and direction from nearest town or city: 5 1/2 E Owner of well: Edwin R. Schmidt  
Street address of well location if in city: Buhler R.R. or street: RR 1  
City, state, zip code: Moundridge KS 67109

3. Locate with "X" in section below: Sketch map: 

4. Bore hole dia. 10 in. Completion date 8-26-76  
Well depth 110 ft.

7. ☐ Cable tool ☐ Rotary ☒ Driven ☐ Dug  
☐ Hollow rod ☐ Jetted ☐ Bored ☐ Reverse rotary

8. Use: ☒ Domestic ☐ Public supply ☐ Industry  
☐ Irrigation ☐ Air conditioning ☒ Stock  
☐ Lawn ☐ Oil field water ☐ Other

9. Casing: Material PVC Height: 90 or below  
Threaded ☐ Welded ☐ Surface 90 in.  
RMP PVC Weight 140 lbs./ft.  
Dia. 5 in. to 110 ft. depth Wall Thickness: inches 1.312  
Dia. 5 in. to 110 ft. depth Gauge No. 1.312

10. Screen: Manufacturer's name Certain Tech  
Type PVC Dia. 5"  
Slot/gauze 76 Length 10'  
Set between 100 ft. and 110 ft.  
Gravel pack? ☒ Size range of material 4-20

11. Static water level: 70 ft. below land surface Date 8-26-76 mo./day/yr.

12. Pumping level below land surfaces:  
\_\_\_\_ ft. after \_\_\_\_ hrs. pumping \_\_\_\_ g.p.m.  
\_\_\_\_ ft. after \_\_\_\_ hrs. pumping \_\_\_\_ g.p.m.  
Estimated maximum yield \_\_\_\_ g.p.m.

13. Water sample submitted: \_\_\_\_ mo./day/yr.  
Yes ☒ No ☐ Date \_\_\_\_

14. Well head completion:  
☒ Pitless adapter \_\_\_\_ inches above grade

15. Well grouted? ☒  
With: ☐ Neat cement ☐ Bentonite ☒ Concrete  
Depth: From 4 ft. to 14 ft.

16. Nearest source of possible contamination: Barn  
ft. 20 Direction W Type yard  
Well disinfected upon completion? ☒ Yes ☐ No

17. Pump: ☒ Not installed  
Manufacturer's name \_\_\_\_ HP \_\_\_\_ Volts \_\_\_\_  
Model number \_\_\_\_ Length of drop pipe \_\_\_\_ ft. capacity \_\_\_\_ g.p.m.  
Type: ☐ Submersible ☐ Turbine  
☐ Jet ☐ Reciprocating  
☐ Centrifugal ☐ Other

18. Elevation: Topography: ☒ Hill ☒ Slope ☐ Upland ☐ Valley

19. Remarks: (Use a second sheet if needed)

20. Water well contractor's certification:  
This well was drilled under my jurisdiction and this report is true to the best of my knowledge and belief.  
Backhus Drg. License No. 180  
Business name Tampa KS  
Address Tampa KS  
Signed Paul Backhus Date 9-13-76  
Authorized representative

22-30-17  
Sec 17  
1/4 1/4 1/4  
NUNENE