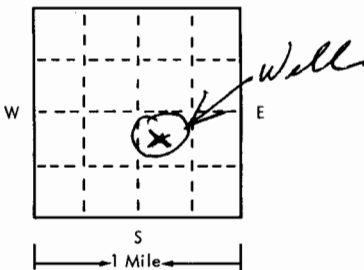


USE TYPEWRITER OR BALL
POINT PEN-PRESS FIRMLY,
PRINT CLEARLY.

WATER WELL RECORD
KSA 82a-1201-1215

T R EW sec 1/4 1/4 1/4 No.

Kansas State Dept. Of Health
(Water Well Contractors)
Forbes-Bldg. 740
Topeka, Kansas 66620

1 Location of well:	County HARVEY	Township name ALTA	Fraction SE 1/4	Section number 23	Town number T-225	Range number R-3-W
Distance and direction from nearest town or city: 12 miles S.W.				3 Owner of well: WILLIS HARDER		
Street address of well location if in city: MOUNDRIE, KS				Address: RR1 MOUNDRIE KANS		
Locate with "X" in section below: 				4 Well depth: 89 ft. Date of completion 11-1-75 Well diameter 30 in.		
2 Type and color of material				5 <input type="checkbox"/> Cable tool <input type="checkbox"/> Rotary <input type="checkbox"/> Driven <input type="checkbox"/> Dug <input type="checkbox"/> Hollow rod <input type="checkbox"/> Jetted <input type="checkbox"/> Bored <input checked="" type="checkbox"/> Reverse rotary		
				6 Use: <input type="checkbox"/> Domestic <input type="checkbox"/> Public supply <input type="checkbox"/> Industry <input checked="" type="checkbox"/> Irrigation <input type="checkbox"/> Air conditioning <input type="checkbox"/> Commercial <input type="checkbox"/> Test well		
From To				7 Casing: Material transite Height: above/below Threaded <input type="checkbox"/> Welded <input type="checkbox"/> Surface 12 in. Diam. 16 in. to 89 ft. depth Drive shoe? <input type="checkbox"/> Yes <input checked="" type="checkbox"/> No		
				8 Screen: Manufacturer AURORA TILE CO Type TRANSITE Dia. 16" I.D. Slot/gauze 1/8 Length 39 Set between 50 ft. and 89 ft. Fittings: Gravel pack <input checked="" type="checkbox"/> Yes <input type="checkbox"/> No Size range of material 24"		
Good water here				9 Static water level: 38 ft. below land surface Date 11-1-75		
				10 Pumping level below land surfaces: 70 ft. after 2 hrs. pumping 1000 g.p.m. ____ ft. after ____ hrs. pumping ____ g.p.m. Estimated maximum yield 1000 g.p.m.		
Good water here				11 Water sample submitted: <input checked="" type="checkbox"/> Yes <input type="checkbox"/> No Date 11-1-75		
				12 Well head completion: <input type="checkbox"/> Pitless adapter 18 inches above grade		
Cased 89 ft 16" 10. Transite casing.				13 Well grouted? <input checked="" type="checkbox"/> Yes <input type="checkbox"/> No <input type="checkbox"/> Neat cement <input type="checkbox"/> Bentonite <input checked="" type="checkbox"/> Clay Depth: From 0 ft. to 10 ft.		
				14 Nearest source of possible contamination: ft. 1300 Direction W Type Well Well disinfected upon completion? <input type="checkbox"/> Yes <input checked="" type="checkbox"/> No		
(use a second sheet if needed)				15 Pump: <input type="checkbox"/> Not installed Manufacturer's name WESTERN LAND POLICE Model number 800 HP 40 Volts ____ Length of drop pipe 85 ft. capacity 1000 g.m.p. Type: <input type="checkbox"/> Submersible <input checked="" type="checkbox"/> Turbine <input type="checkbox"/> Jet <input type="checkbox"/> Reciprocating <input type="checkbox"/> Centrifugal <input type="checkbox"/> Other		
				16 Remarks: elevation FLAT LAND		
17 Water well contractor's certification: This well was drilled under my jurisdiction and this report is true to the best of my knowledge and belief. PETERSON BAOS INC 138 Business name License No. Address Lindsburg, Kans Signed Wally Peterson Date 11-1-75 Authorized representative						