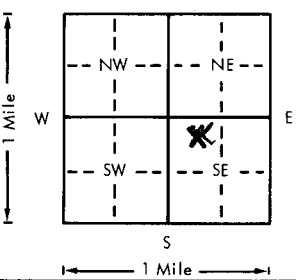
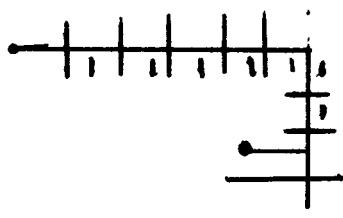


USE TYPEWRITER OR BALL
POINT PEN-PRESS FIRMLY,
PRINT CLEARLY.

WATER WELL RECORD
KSA 82a-1201-1215

Kansas Department of Health and
Environment-Division of Environment
(Water well Contractors)
Topeka, Kansas 66620

| | | | | | | |
|---|--|---|---|--|----------------------------------|--|
| 1. Location of well: | | County Harvey | Fraction NE 1/4 NW 1/4 SE 1/4 | Section number 30 | Township number T 22 S | Range number R 3 E 10 |
| 2. Distance and direction from nearest town or city: Street address of well location if in city: 5 mi. east of Buhler cemetery, 2 1/2 mi. south, 3/4 mi. west | | | | 3. Owner of well: Kenneth Stucky R.R. or street: RFD City, state, zip code: Burrton, Kansas 67020 | | |
| 4. Locate with "X" in section below: | | Sketch map: | | 6. Bore hole dia. 6 in. Completion date 4/30/79 Well depth 65 ft. | | |
|  | |  | | 7. <input checked="" type="checkbox"/> Cable tool <input checked="" type="checkbox"/> Rotary <input type="checkbox"/> Driven <input type="checkbox"/> Dug <input type="checkbox"/> Hollow rod <input type="checkbox"/> Jetted <input type="checkbox"/> Bored <input type="checkbox"/> Reverse rotary | | |
| 5. Type and color of material | | From | To | 8. Use: <input type="checkbox"/> Domestic <input type="checkbox"/> Public supply <input type="checkbox"/> Industry <input type="checkbox"/> Irrigation <input type="checkbox"/> Air conditioning <input type="checkbox"/> Stock <input type="checkbox"/> Lawn <input checked="" type="checkbox"/> Oil field water <input type="checkbox"/> Other | | |
| Top soil | | 0 | 3 | 9. Casing: Material Plastic Height: Above or below Threaded <input type="checkbox"/> Welded <input type="checkbox"/> Surface 8 in. RMP <input type="checkbox"/> PVC <input checked="" type="checkbox"/> Weight 160 lbs./ft. Dia. 3 in. to 0 ft. depth Wall Thickness: inches or Dia. 45 in. to 45 ft. depth gage No. _____ | | |
| Fine sand & clay | | 3 | 18 | 10. Screen: Manufacturer's name Certain teel sawed Type Sawed Dia. 3 Slot/gauze 1/4 Length 20 Set between 45 ft. and 65 ft. ft. and _____ ft. | | |
| Gray clay | | 18 | 30 | Gravel pack? yes Size range of material 1/2 x 1/4 | | |
| Equis sand | | 30 | 61 | 11. Static water level: _____ mo./day/yr. 11'8" ft. below land surface Date 4-30-79 | | |
| Green clay | | 61 | 65 | 12. Pumping level below land surfaces: 15 ft. after 1 hrs. pumping 80 g.p.m. _____ ft. after _____ hrs. pumping _____ g.p.m. Estimated maximum yield 100 g.p.m. | | |
| | | | | 13. Water sample submitted: _____ mo./day/yr. Yes <input type="checkbox"/> No <input checked="" type="checkbox"/> Date _____ | | |
| | | | | 14. Well head completion: 8 inches above grade <input type="checkbox"/> Pitless adapter | | |
| | | | | 15. Well grouted? yes With: <input checked="" type="checkbox"/> Neat cement <input checked="" type="checkbox"/> Bentonite _____ Concrete Depth: From 0 ft. to 10 ft. | | |
| | | | | 16. Nearest source of possible contamination: ft. _____ Direction none Type _____ Well disinfected upon completion? Yes <input type="checkbox"/> No <input checked="" type="checkbox"/> | | |
| | | | | 17. Pump: <input checked="" type="checkbox"/> Not installed Manufacturer's name _____ Model number _____ HP _____ Volts _____ Length of drop pipe _____ ft. capacity _____ g.p.m. Type: <input type="checkbox"/> Submersible <input type="checkbox"/> Turbine <input type="checkbox"/> Jet <input type="checkbox"/> Reciprocating <input type="checkbox"/> Centrifugal <input type="checkbox"/> Other | | |
| 18. Elevation: | | 19. Remarks: | | 20. Water well contractor's certification: This well was drilled under my jurisdiction and this report is true to the best of my knowledge and belief. Rosencrantz-Bemis Ent. Inc. License No. 134 Business name Address 1211 W. 4th Hutchinson, Kan Signed Mike Flawes Date 6-9-79 Authorized representative | | |

22-30 SE 1/4 NE 1/4