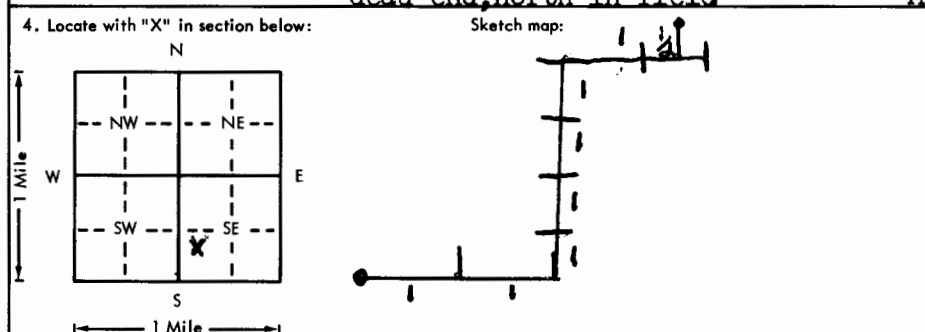


USE TYPEWRITER OR BALL
POINT PEN-PRESS FIRMLY,
PRINT CLEARLY.

WATER WELL RECORD
KSA 82a-1201-1215

Kansas Department of Health and
Environment-Division of Environment
(Water well Contractors)
Topeka, Kansas 66620

1. Location of well:		County Harvey	Fraction NW 1/4 SW 1/4 SE 1/4	Section number 36	Township number T 22 S R 3 E	Range number 3
2. Distance and direction from nearest town or city:		2 mi. east, 4 mi. north, 1 1/2 mi. east to dead end, north in field				
3. Owner of well:		Blackstone Drilling Co. P.O. Box 1184 McPherson, Kansas 67460				
4. Locate with "X" in section below:		Sketch map:				
						
5. Type and color of material		From To				
Top soil		0 3				
Clay		3 18				
Sandy clay streak		18 21				
Clay		21 28				
Sandy clay streak		28 30				
Clay		30 40				
Fine sand and clay		40 43				
Clay		43 45				
Clay with fine sand		45 48				
Fine & med. sand with clay		48 53				
Clay		53 58				
Clay & fine sand		58 60				
Clay & fine sand		60 75				
Fine sand		75 78				
Med. fine sand		78 97				
Fine sand & clay		97 105				
(Use a second sheet if needed) Shale		105 120				
18. Elevation:		19. Remarks:				
Topography: Hill Slope Upland Valley		20. Water well contractor's certification: This well was drilled under my jurisdiction and this report is true to the best of my knowledge and belief. Business name: Rosenblatt & Sons, Inc. License No. 134 Address: 1211 W. 4th, Hutchinson, Kansas Signed: Mike Rosen Date: 6-18-79 Authorized representative				

Forward the white, blue and pink copies to the Department of Health and Environment

Form WWC-5