

1	LOCATION OF WATER WELL:	Fraction	Section Number	Township Number	Range Number
County:	Harvey	NW ¼ SE ¼ SW ¼	11	T 22 S	R 3 E (W)

Distance and direction from nearest town or city street address of well if located within city?

8 mi E, 1/4 N of Buhler - 18828 W Dutch Ave


2	WATER WELL OWNER:
---	-------------------

RR#, St. Address, Box # : 18828 W Dutch Ave
City, State, ZIP Code : Moundridge, KS 67107

Board of Agriculture, Division of Water Resources
Application Number:

3 LOCATE WELL'S LOCATION WITH AN "X" IN SECTION BOX:

4 DEPTH OF COMPLETED WELL 89 ft. ELEVATION:

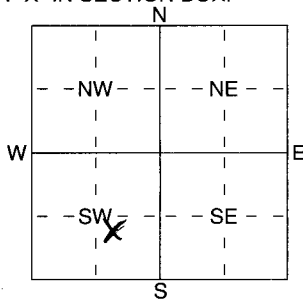

Depth(s) Groundwater Encountered 1 ft. 2 ft. 3 ft.
WELL'S STATIC WATER LEVEL 29 ft. below land surface measured on mo/day/yr 12-2-03
Pump test data: Well water was 40 ft. after 1/2 hours pumping 25 gpm
Est. Yield gpm: Well water was ft. after hours pumping gpm
WELL WATER TO BE USED AS: 5 Public water supply 8 Air conditioning 11 Injection well
① Domestic 3 Feedlot 6 Oil field water supply 9 Dewatering 12 Other (Specify below)
2 Irrigation 4 Industrial 7 Domestic (lawn & garden) 10 Monitoring well

Was a chemical/bacteriological sample submitted to Department? Yes No X; If yes, mo/day/lys sample was submitted
Water Well Disinfected? Yes X No

5	TYPE OF BLANK CASING USED:
---	----------------------------

5 Wrought iron	8 Concrete tile
6 Asbestos-Cement	9 Other (specify below)
7 Fiberglass	

CASING JOINTS: Glued ☒..... Clamped

Welded

Threaded

Blank casing diameter 5 in. to 79 ft., Dia _____ in. to _____ ft., Dia _____ in. to _____ ft.

Casing height above land surface 12 in., weight 2.29 lbs./ft. Wall thickness or gauge No. 160

TYPE OF SCREEN OR PERFORATION MATERIAL:

5 Fiberglass	7 PVC	10 Asbestos-Cement
6 Concrete tile	8 RMP (SR)	11 Other (Specify)
	9 ABS	12 None used (open hole)

SCREEN OR PERFORATION OPENINGS ARE:

5 Guazed wrapped 8 Saw cut 11 None (open hole)
6 Wire wrapped 9 Drilled holes
7 Torch cut 10 Other (specify)

SCREEN-PERFORATED INTERVALS: From 79 ft. to 89 ft., From _____ ft. to _____ ft.

GRAVEL PACK INTERVALS: From 23 ft. to 91 ft. From _____ ft. to _____ ft.
From _____ ft. to _____ ft. From _____ ft. to _____ ft.

6	GROUT MATERIAL:
---	-----------------

1 Neat cement 2 Cement grout 3 Bentonite 4 Other

Grout Intervals: From 3 ft. to 23 ft., From _____ ft. to _____ ft., From _____ ft. to _____ ft.

What is the nearest source of possible contamination:

7 Pit privy	10 Livestock pens	14 Abandoned water well
8 Sewage lagoon	11 Fuel storage	15 Oil well/Gas well
9 Feedyard	12 Fertilizer storage	16 Other (specify below)
	13 Insecticide storage	

Direction from well?

How many feet? 12.5

[illegible]

7. CONTRACTOR'S OR LANDOWNER'S CERTIFICATION: This water well was (1) constructed, (2) reconstructed, or (3) plugged under my jurisdiction and was completed on (mo/day/year) 12-2-02 and this record is true to the best of my knowledge and belief. Kansas Water Well Contractor's Licence No 447 This Water Well Record was completed on (mo/day/yr) 12-9-02 under the business name of Miller Drilling by (signature) E Miller