


LOG

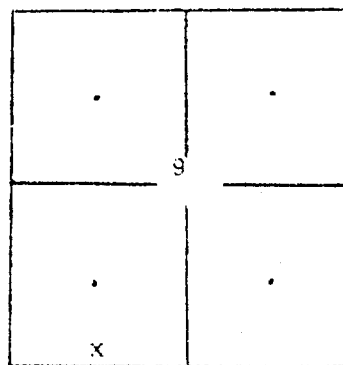

A
N
|||

SECTION

Of _____ Test _____ No. 1
 For John & Paul Ratzlaff
 Date Drilled 9-6-84
 Location: SW₄ Sec. 9 T 22 S R 3 W/E
Harvey Co., Kansas

Depth	Formation Thickness	Formation	Remarks
0-49		Topsoil & brown clay	
49-72		Sand & gravel, fine, clean w/a few thin streaks of green shale	
72-75		Soft gray clay	
75-90		Sand & gravel, fine, clean	
90-105		Sand & gravel, fine, clean w/a few thin clay streaks	
105-131		Sand & gravel, fine some med. w/a lot of thin green clay streaks	
131-133		Soft gray clay	
133-135		Sand & gravel, med.	
135-165		Sand & gravel, fine, clean w/a few thin clay streaks	
165-180		Sand & gravel, fine to very fine w/a few thin clay streaks	
180-204		Sand & gravel, fine clean w/a few thin clay streaks	
204-207		Gray & red shale	

RECEIVED

RECEIVED

NOV - 7 2003

Static Water Level _____ 51'

NOV 17 2003

EQUUS BEDS GROUNDWATER
MANAGEMENT DISTRICT NO.

BUREAU OF WATER

WATER SAMPLES

PPM-Chloride

Other Tests

184 to 204

49

to

to

to

206 feet of 2 1/2" pipe was left for supply well.

BY: Rodney Schenkel