

1	LOCATION OF WATER WELL:	Fraction	Section Number	Township Number	Range Number
County:	Harvey	NW 1/4 NW 1/4 NE 1/4	25	T 22 S	R 3 E/W


Distance and direction from nearest town or city street address of well if located within city?

7 North, 2 East of Burrton, Ks

2 WATER WELL OWNER: Mark Vogts  
RR#, St. Address, Box # : 1795 Arapaho Road  
City, State, ZIP Code : Moundridge, Ks. 67107

Board of Agriculture, Division of Water Resources  
Application Number:

3 LOCATE WELL'S LOCATION WITH AN "X" IN SECTION BOX:	4 DEPTH OF COMPLETED WELL ..... 57 ..... ft. ELEVATION: ..... <div style="margin-top: 10px;">           Depth(s) Groundwater Encountered      1                          ft 2                          ft 3                          ft         </div>
--	---

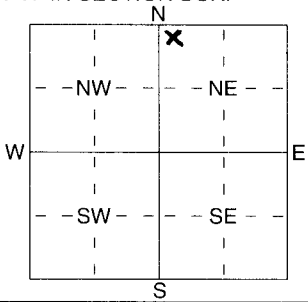

Depth(s) Groundwater Encountered 1 ..... ft. 2 ..... ft. 3 ..... ft.  
WELL'S STATIC WATER LEVEL ..... 14 ..... ft. below land surface measured on mo/day/yr 4/20/04  
Pump test data: Well water was ..... ft. after ..... hours pumping ..... gpm  
Est. Yield ..... gpm: Well water was ..... ft. after ..... hours pumping ..... gpm  
WELL WATER TO BE USED AS: 5 Public water supply 8 Air conditioning 11 Injection well  
1 Domestic 3 Feedlot 6 Oil field water supply 9 Dewatering 12 Other (Specify below)  
2 Irrigation 4 Industrial 7 Domestic (lawn & garden) 10 Monitoring well ..... STOCK

Was a chemical/bacteriological sample submitted to Department? Yes ..... No X .....; If yes, mo/day/yr sample was submitted  
Water Well Disinfected? Yes X ..... No

5	TYPE OF BLANK CASING USED:		5 Wrought iron	8 Concrete tile	CASING JOINTS: <u>Glued</u> ..... Clamped .....
	1 Steel	3 RMP (SR)	6 Asbestos-Cement	9 Other (specify below)	Welded .....
	2 <u>PVC</u>	4 <u>ABS</u>	7 Fiberglass	.....	Threaded .....

Blank casing diameter 4 in. to 37 ft., Dia \_\_\_\_\_ in. to \_\_\_\_\_ ft., Dia \_\_\_\_\_ in. to \_\_\_\_\_ ft.  
Casing height above land surface 24 in., weight 160# lbs./ft. Wall thickness or gauge No. .173

TYPE OF SCREEN OR PERFORATION MATERIAL:

1 Steel	3 Stainless Steel	5 Fiberglass	7 <del>PVC</del>	10 Asbestos-Cement
2 Brass	4 Galvanized Steel	6 Concrete tile	8 RMP (SR)	11 Other (Specify) .....
			9 ABS	12 None used (open hole)

SCREEN OR PERFORATION OPENINGS ARE:

1 Continuous slot	3 Mill slot	5 Guazed wrapped	8 <u>Saw cut</u>	11 None (open hole)
2 Louvered shutter	4 Key punched	6 Wire wrapped	9 Drilled holes	
		7 Torch cut	10 Other (specify) .....	ft.

SCREEN-PERFORATED INTERVALS: From 31 ft. to 57 ft., From \_\_\_\_\_ ft. to \_\_\_\_\_ ft.  
From \_\_\_\_\_ ft. to \_\_\_\_\_ ft., From \_\_\_\_\_ ft. to \_\_\_\_\_ ft.

GRAVEL PACK INTERVALS: From 57 ft. to 20 ft., From \_\_\_\_\_ ft. to \_\_\_\_\_ ft.  
From \_\_\_\_\_ ft. to \_\_\_\_\_ ft., From \_\_\_\_\_ ft. to \_\_\_\_\_ ft.

6 GROUT MATERIAL: 1 Neat cement 2 Cement grout 3 Bentonite 4 Other Hole Plug  
Grout Intervals: From 20 ft. to 0 ft., From \_\_\_\_\_ ft. to \_\_\_\_\_ ft., From \_\_\_\_\_ ft. to \_\_\_\_\_ ft., From \_\_\_\_\_ ft. to \_\_\_\_\_ ft.

What is the nearest source of possible contamination:

1 Septic tank	4 Lateral lines	7 Pit privy	10 Livestock pens	14 Abandoned water well
2 Sewer lines	5 Cess pool	8 Sewage lagoon	11 Fuel storage	15 Oil well/Gas well
3 Watertight sewer lines	6 Seepage pit	9 Feedyard	12 Fertilizer storage	16 Other (specify below)

Direction from well? *West*

How many feet? *60*

*buried gas line*

[illegible]

7. CONTRACTOR'S OR LANDOWNER'S CERTIFICATION: This water well was (1) constructed, (2) reconstructed, or (3) plugged under my jurisdiction and was completed on (mo/day/year) 4/30/04 and this record is true to the best of my knowledge and belief. Kansas Water Well Contractor's Licence No. 134 This Water Well Record was completed on (mo/day/yr) 5/10/04 under the business name of Rosecrans, Bernis Ent. by (signature) Jessie Dodson