

RECEIVED

OCT 20 2004

1	LOCATION OF WATER WELL:	Fraction	Section	Number	Township	Number	Range	Number
County: HARVEY		$\frac{1}{4}$ SE $\frac{1}{4}$ NE $\frac{1}{4}$ SW	16		22 SOUTH			

Distance and direction from nearest town or city street address of well if located within city?

FROM BUHLER, KS: 6.5 MILES EAST & .75 MILES SOUTH

2 WATER WELL OWNER: HENRY SIEMENS


RR #, St. Address, Box #: P.O. BOX 168

City, State, ZIP Code : MOUNDRIDGE, KS 67107

Board of Agriculture, Division of Water Resources

Application Number: 22311

3 MARK WELL'S LOCATION WITH AN "X" IN SECTION BOX:

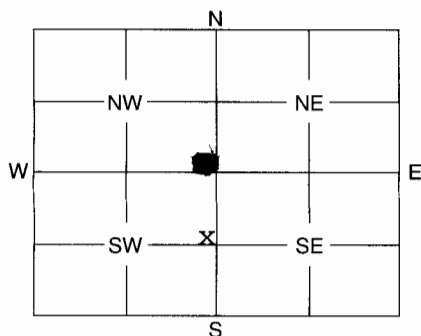

4 DEPTH OF WELL 206.5 ft.

WELL'S STATIC WATER LEVEL 41.5 ft.

WELL WAS USED AS:

1 Domestic

2 Irrigation

3 Feedlot

4 Industrial

5 Public Water Supply

6 Oil Field Water Supply

7 Domestic (Lawn & Garden)

8 Air Conditioning

9 Dewatering

10 Monitoring Well

11 Injection Well

12 Other

Was a chemical / bacteriological sample submitted to Department? Yes No ☒ X

If yes, mo/day/yr sample was submitted

Water Well Disinfected: Yes ☒ X No

5 TYPE OF BLANK CASING USED:

1 Steel

3 RMP (SR)

5 Wrought

7 Fiberglass

9 Other (Specify below)

2 PVC

4 ABS

6 Asbestos-Cement

8 Concrete Tile

Blank casing diameter 1.6 in.

Was casing pulled?

Yes

No ☒ X

If yes, how much

Casing height ~~30.0~~ below land surface 3.6 in.

6 GROUT PLUG MATERIAL: 1 Neat cement 2 Cement grout 3 Bentonite 4 Other

Grout Plug Intervals: From 41 ft. to 3 ft., From ft. to ft., From ft. to ft.

What is the nearest source of possible contamination:

1 Septic tank

2 Sewer lines

3 Watertight sewer lines

4 Lateral lines

5 Cess pool

6 Seepage pit

7 Pit privy

8 Sewage lagoon

9 Feedyard

10 Livestock pens

11 Fuel storage

12 Fertilizer storage

13 Insecticide storage

14 Abandoned water well

15 Oil well/Gas well

16 Other (specify below)

Direction from well? WEST

How many feet? APPROX 100

FROM	TO	PLUGGING MATERIALS
206.5	41	SAND
41	3	NEAT CEMENT
3	0	TOPSOIL

NOTE: GROUT PORTION OF PLUGGING
WITNESSED BY TIM BOESE, EQUUS
BEDS GMD2

7 CONTRACTOR'S OF LANDOWNER'S CERTIFICATION: This water well was plugged under my jurisdiction and was completed on (mo/day/year) 10/16/04 and this record is true to the best of my knowledge and belief. Kansas Water Well Contractor's License No. NA This Water Well Record was completed on (mo/day/year) 10/16/04 under the business name of NA by (signature) Henry Siemens

INSTRUCTIONS: Use typewriter or ball point pen. Please press firmly and print clearly. Please fill in blanks, underline or circle the correct answers. Send top three copies to Kansas Department of Health and Environment, Bureau of Water, Geology Section, 1000 SW Jackson St., Ste. 420, Topeka, Kansas 66612-1367. Telephone: 785/296-5522. Send one to Water Well Owner and retain one for your records.