CORRECTION(S) TO WATER WELL RECORD (WWC-5)
(to rectify lacking or incorrect information)

County: Harvey

Location listed as:	**Location changed to:**
Section-Township-Range: 26-23 S-3 W	26-22 S-3 W
Fraction (¼ ¼ ¼): SW SW SW	SW SW SW

Other changes: Initial statements: _____

Changed to: _____

Comments: _____

verification method: Water right information in WIMAS database, county ownership map, and mapping tool on KGS website.

initials: DRL date: 1/28/2011

submitted by: Kansas Geological Survey, Data Resources Library, 1930 Constant Ave., Lawrence, KS 66047-3726
to: Kansas Dept of Health & Environment, Bureau of Water, 1000 SW Jackson, Suite 420, Topeka, KS 66612-1367.

WATER WELL RECORD Form WWC-5 KSA 82a-1212 ID No. _____

1 LOCATION OF WATER WELL: County: Harvey | Fraction: SW ¼ SW ¼ SW ¼ | Section Number: 26 | Township Number: T 23 S | Range Number: R 3 E (W)

Distance and direction from nearest town or city street address of well if located within city?
From Burrton, KS 8 miles North + 2 East +

2 WATER WELL OWNER: Tillie Schrag Rev. Trust
RR#, St. Address, Box # : 1637 N. West Parkway
City, State, ZIP Code : Wichita, KS 67212
Board of Agriculture, Division of Water Resources Application Number: 45,672

3 LOCATE WELL'S LOCATION WITH AN "X" IN SECTION BOX:

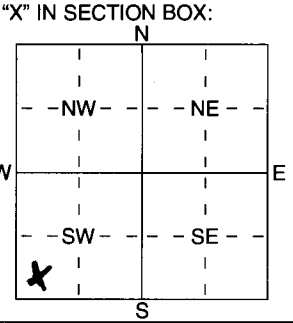

4 DEPTH OF COMPLETED WELL 85 ft. ELEVATION:
Depth(s) Groundwater Encountered 1 15 ft. 2 ft. 3 ft.
WELL'S STATIC WATER LEVEL 15 ft. below land surface measured on mo/day/yr 10-20-05
Pump test data: Well water was 45 ft. after 2 hours pumping 700 gpm
Est. Yield 700 gpm: Well water was ft. after hours pumping gpm
WELL WATER TO BE USED AS: 1 Domestic 2 Irrigation 3 Feedlot 4 Industrial 5 Public water supply 6 Oil field water supply 7 Domestic (lawn & garden) 8 Air conditioning 9 Dewatering 10 Monitoring well 11 Injection well 12 Other (Specify below)
Was a chemical/bacteriological sample submitted to Department? Yes No X; If yes, mo/day/yrs sample was submitted
Water Well Disinfected? Yes X No

5 TYPE OF BLANK CASING USED: 1 Steel 2 PVC 3 RMP (SR) 4 ABS 5 Wrought iron 6 Asbestos-Cement 7 Fiberglass 8 Concrete tile 9 Other (specify below)
CASING JOINTS: Glued X Clamped Welded Threaded
Blank casing diameter 16 in. to 45 ft., Dia in. to ft., Dia in. to ft.
Casing height above land surface 12 in., weight 16 lbs./ft. Wall thickness or guage No. Sch. 40
TYPE OF SCREEN OR PERFORATION MATERIAL: 1 Steel 2 Brass 3 Stainless Steel 4 Galvanized Steel 5 Fiberglass 6 Concrete tile 2 PVC 8 RMP (SR) 9 ABS 10 Asbestos-Cement 11 Other (Specify) 12 None used (open hole)
SCREEN OR PERFORATION OPENINGS ARE: 1 Continuous slot 2 Louvered shutter 3 Mill slot 4 Key punched 5 Guazed wrapped 6 Wire wrapped 7 Torch cut 8 Saw cut 9 Drilled holes 10 Other (specify) 11 None (open hole)
SCREEN-PERFORATED INTERVALS: From 45 ft. to 85 ft., From ft. to ft.
From ft. to ft., From ft. to ft.
GRAVEL PACK INTERVALS: From 20 ft. to 85 ft., From ft. to ft.
From ft. to ft., From ft. to ft.

6 GROUT MATERIAL: 1 Neat cement 2 Cement grout 3 Bentonite 4 Other
Grout Intervals: From 3 ft. to 20 ft., From ft. to ft., From ft. to ft.
What is the nearest source of possible contamination: 1 Septic tank 2 Sewer lines 3 Watertight sewer lines 4 Lateral lines 5 Cess pool 6 Seepage pit 7 Pit privy 8 Sewage lagoon 9 Feedyard 10 Livestock pens 11 Fuel storage 12 Fertilizer storage 13 Insecticide storage 14 Abandoned water well 15 Oil well/Gas well 16 Other (specify below) None
Direction from well? How many feet? 0pm Field

FROM	TO	LITHOLOGIC LOG	FROM	TO	PLUGGING INTERVALS
0	2	Fine Sand Topsoil			
2	10	Dark Clay			
10	40	Tan Clay			
40	55	Medium Sand + Small Gravel			
55	60	Medium Sand w/clay			
60	65	Tan Clay			
65	82	Medium Sand + Small Gravel			
82	85	Green Shale			

7 CONTRACTOR'S OR LANDOWNER'S CERTIFICATION: This water well was (1) constructed, (2) reconstructed, or (3) plugged under my jurisdiction and was completed on (mo/day/year) 10-20-05 and this record is true to the best of my knowledge and belief. Kansas Water Well Contractor's Licence No. 238 This Water Well Record was completed on (mo/day/yr) 10-25-05 under the business name of Wenger Irrigation by (signature) Clyde Wenger

INSTRUCTIONS: Use typewriter or ball point pen. PLEASE PRESS FIRMLY and PRINT clearly. Please fill in blanks, underline or circle the correct answers. Send top three copies to Kansas Department of Health and Environment, Bureau of Water, Geology Section, 1000 SW Jackson St., Suite 420, Topeka, Kansas 66612-1367. Telephone 785-296-5522. Send one to WATER WELL OWNER and retain one for your records. Fee of $5.00 for each constructed well.