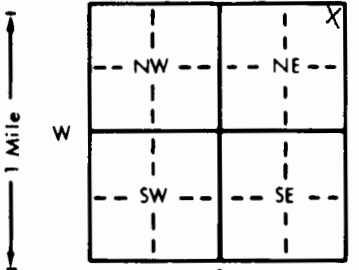


1 LOCATION OF WATER WELL: County: <u>Harvey</u>		Fraction <u>NE 1/4 NE 1/4 NE 1/4</u>	Section Number <u>7</u>	Township Number <u>T 22 S</u>	Range Number <u>R 3</u> <u>EW</u>
Distance and direction from nearest town or city street address of well if located within city? <u>5 mi E Buhler IN W side</u>					
2 WATER WELL OWNER: <u>Equus Beds BMO2</u> RR#, St. Address, Box # <u>313 Spruce</u> City, State, ZIP Code <u>Holstead KS 67056</u>		Board of Agriculture, Division of Water Resources Application Number: <u>EB37B</u>			
3 LOCATE WELL'S LOCATION WITH AN "X" IN SECTION BOX: 		4 DEPTH OF COMPLETED WELL <u>165</u> ft. ELEVATION: Depth(s) Groundwater Encountered <u>1</u> ft. 2. ft. 3. ft. WELL'S STATIC WATER LEVEL <u>45</u> ft. below land surface measured on mo/day/yr <u>2-8-93</u> Pump test data: Well water was ft. after hours pumping gpm Est. Yield gpm: Well water was ft. after hours pumping gpm Bore Hole Diameter in. to ft. and in. to ft. WELL WATER TO BE USED AS: 5 Public water supply 8 Air conditioning 11 Injection well 1 Domestic 3 Feedlot 6 Oil field water supply 9 Dewatering 12 Other (Specify below) 2 Irrigation 4 Industrial 7 Lawn and garden only 10 Monitoring well Was a chemical/bacteriological sample submitted to Department? Yes No <u>X</u> ; If yes, mo/day/yr sample was submitted Water Well Disinfected? Yes No <u>X</u>			
5 TYPE OF BLANK CASING USED: 1 Steel 3 RMP (SR) 5 Wrought iron 8 Concrete tile 2 PVC 4 ABS 6 Asbestos-Cement 9 Other (specify below) Blank casing diameter <u>2</u> in. to <u>155</u> ft. Dia. in. to ft. Dia. in. to ft. Casing height above land surface <u>36</u> in. weight <u>Sec 40</u> lbs./ft. Wall thickness or gauge No. TYPE OF SCREEN OR PERFORATION MATERIAL: 1 Steel 3 Stainless steel 5 Fiberglass 7 PVC 10 Asbestos-cement 2 Brass 4 Galvanized steel 6 Concrete tile 8 RMP (SR) 11 Other (specify) SCREEN OR PERFORATION OPENINGS ARE: 1 Continuous slot 3 Mill slot 5 Gauzed wrapped 8 Saw cut 11 None (open hole) 2 Louvered shutter 4 Key punched 6 Wire wrapped 9 Drilled holes SCREEN-PERFORATED INTERVALS: From <u>155</u> ft. to <u>165</u> ft. From ft. to ft. GRAVEL PACK INTERVALS: From <u>160</u> ft. to <u>165</u> ft. From ft. to ft. FROM TO LITHOLOGIC LOG FROM TO PLUGGING INTERVALS					
6 GROUT MATERIAL: 1 Neat cement 2 Cement grout 3 Bentonite 4 Other Grout Intervals: From <u>0</u> ft. to <u>150</u> ft. From ft. to ft. From ft. to ft. What is the nearest source of possible contamination: 1 Septic tank 4 Lateral lines 7 Pit privy 10 Livestock pens 14 Abandoned water well 2 Sewer lines 5 Cess pool 8 Sewage lagoon 11 Fuel storage 15 Oil well/Gas well 3 Watertight sewer lines 6 Seepage pit 9 Feedyard 12 Fertilizer storage 16 Other (specify below) Direction from well? How many feet? <u>NONE</u>					
7 CONTRACTOR'S OR LANDOWNER'S CERTIFICATION: This water well was (1) <u>constructed</u> , (2) reconstructed, or (3) plugged under my jurisdiction and was completed on (mo/day/year) <u>2-8-93</u> and this record is true to the best of my knowledge and belief. Kansas Water Well Contractor's License No. <u>537</u> This Water Well Record was completed on (mo/day/yr) <u>2-23-93</u> under the business name of <u>Flowers Drilling</u> by (signature) <u>Mike Flowers</u>					