

LOCATION OF WATER WELL: HARVEY	Fraction SW ¼ SW ½ NW ¼	Section Number 19	Township Number 22 SOUTH	Range Number 03 WEST
-----------------------------------	----------------------------	----------------------	-----------------------------	-------------------------


Distance and direction from nearest town or city street address of well if located within city?

APPROXIMATELY 3.5 MILES EAST AND 0.5 MILES SOUTH OF BUHLER, KS

WATER WELL OWNER:

RR#, St. Address, Box #: EQUUS BEDS GROUNDWATER MANAGEMENT
DISTRICT NO. 2 Board of Agriculture, Division of Water Resources
313 SPRUCE STREET
City, State, ZIP Code: HALSTEAD, KS 67056 Application Number:

MARK WELL'S LOCATION WITH AN "X" IN SECTION BOX

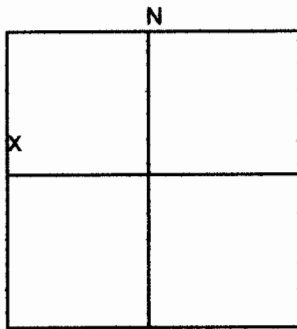

DEPTH OF WELL 114.5 ft.

WELL'S STATIC WATER LEVEL 29.85 ft.

WELL WAS USED AS:

- | | | |
|--------------|--------------------------|-----------------------------------|
| 1 Domestic | 5 Public Water Supply | 9 Dewatering |
| 2 Irrigation | 6 Oil Field Water Supply | 10 Monitoring Well - EB40A |
| 3 Feedlot | 7 Lawn and Garden Only | 11 Injection Well |
| 4 Industrial | 8 Air Conditioning | 12 Other |

Was a chemical/bacteriological sample submitted to Department? Yes ☐ No ☒

If yes, mo/day/yr sample was submitted: / /

WaterWell Disinfected: Yes ☒ No ☐

TYPE OF BLANK CASING USED:

- | | | | | |
|--------------|------------|-------------------|-----------------|---------|
| 1 Steel | 3 RMP (SR) | 5 Wrought | 7 Fiberglass | 9 Other |
| 2 PVC | 4 ABS | 6 Asbestos-Cement | 8 Concrete Tile | |

Blank casing diameter 2.0 in. Was casing pulled? Yes ☐ No ☒ if yes, how much 0.0 ft bls
Casing height above or below land surface 3 feet.

GROUT PLUG MATERIAL: 1 Neat cement 2 Cement grout **3 Bentonite** 4 Other

Grout Plug Intervals: From 114.5 ft. to 3 ft.

What is the nearest source of possible contamination:

- | | | | |
|--------------------------|-------------------|-------------------------|----------|
| 1 Septic tank | 6 Seepage pit | 11 Fuel Storage | 16 Other |
| 2 Sewer lines | 7 Pit privy | 12 Fertilizer storage | |
| 3 Watertight sewer lines | 8 Sewage lagoon | 13 Insecticide storage | |
| 4 Lateral lines | 9 Feedyard | 14 Abandoned water well | |
| 5 Cess Pool | 10 Livestock pens | 15 Oil well / Gas well | |

Direction from well? North-Northwest How many feet? approximately 600 ft.

FROM	TO	PLUGGING MATERIALS
114.5	3	Bentonite, HolePlug
3	0	Topsoil

CONTRACTOR'S OR LANDOWNER'S CERTIFICATION: This water well was plugged under my jurisdiction and was completed on (mo/day/year) 11 / 30 / 2009 and this record is true to the best of my knowledge and belief.
Kansas Water Well Contractor's License No. NA under the business name of Equus Beds GMD2

by (signature) *T. B. GMD2 12-22-09*

INSTRUCTIONS: Use typewriter or ball point pen. Please press firmly and print clearly. Please fill in blanks, and underline or circle the correct answers. Send top three copies to Kansas Department of Health and Environment, Bureau of Water, Topeka, Kansas 66620-0001. Telephone: 913/296-3565. Send one to Water Well Owner and retain one for your records.