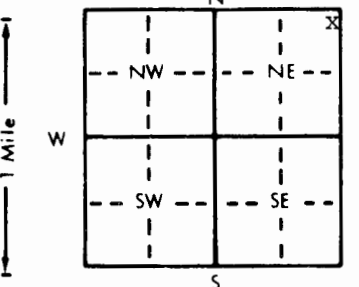


1 LOCATION OF WATER WELL:		Fraction		Section Number		Township Number		Range Number	
County: <u>Harvey</u>		NE 1/4 NE 1/4 NE 1/4		9		T 22 S		R 3 E/W	
Distance and direction from nearest town or city street address of well if located within city? <u>Approximately 9 miles north and 1 mile east of Burrton</u>	
2 WATER WELL OWNER: <u>Equus Beds Ground Water Management District #2</u>	
RR#, St. Address, Box # : <u>313 Spruce</u> Board of Agriculture, Division of Water Resources	
City, State, ZIP Code : <u>Halstead, KS 67056-1925</u> Application Number:	
3 LOCATE WELL'S LOCATION WITH AN "X" IN SECTION BOX:		4 DEPTH OF COMPLETED WELL: <u>158</u> ft. ELEVATION: <u>unknown</u>	
		Depth(s) Groundwater Encountered 1. ft. 2. ft. 3. ft.	
		WELL'S STATIC WATER LEVEL <u>40,35</u> ft. below land surface measured on mo/day/yr <u>11-29-94</u>	
		Pump test data: Well water was <u>not ch'd</u> ft. after hours pumping gpm	
		Est. Yield <u>unknown</u> gpm: Well water was ft. after hours pumping gpm	
		Bore Hole Diameter <u>6 1/4</u> in. to <u>157</u> ft. and in. to ft.	
WELL WATER TO BE USED AS: 5 Public water supply 8 Air conditioning 11 Injection well	
1 Domestic 3 Feedlot 6 Oil field water supply 9 Dewatering 12 Other (Specify below)	
2 Irrigation 4 Industrial 7 Lawn and garden only 10 Monitoring well <u>Observation Well</u>	
Was a chemical/bacteriological sample submitted to Department? Yes.....No <u>X</u>; If yes, mo/day/yr sample was submitted	
Water Well Disinfected? Yes No <u>X</u>	
5 TYPE OF BLANK CASING USED:	
1 <u>Steel</u> 3 RMP (SR) 5 Wrought iron 8 Concrete tile CASING JOINTS: Glued <u>X</u> Clamped	
2 <u>PVC</u> 4 ABS 6 Asbestos-Cement 9 Other (specify below) Welded	
7 Fiberglass Threaded <u>slip x thread</u>	
Blank casing diameter <u>steel 2</u> in. to <u>7</u> ft., Dia <u>PVC 2</u> in. to <u>145</u> ft., Dia in. to ft.	
Casing height above land surface <u>36</u> in., weight <u>steel 3.65/PVC .70</u> lbs./ft. Wall thickness or gauge No. <u>154</u>	
TYPE OF SCREEN OR PERFORATION MATERIAL:	
1 Steel 3 Stainless steel 5 Fiberglass 8 RMP (SR) 11 Other (specify)	
2 Brass 4 Galvanized steel 6 Concrete tile 9 ABS 12 None used (open hole)	
SCREEN OR PERFORATION OPENINGS ARE:	
1 Continuous slot 3 Mill slot 5 Gauzed wrapped 8 Saw cut 11 None (open hole)	
2 Louvered shutter 4 Key punched 6 Wire wrapped 9 Drilled holes	
7 Torch cut 10 Other (specify)	
SCREEN-PERFORATED INTERVALS: From <u>145</u> ft. to <u>155</u> ft., From ft. to ft.	
From ft. to ft., From ft. to ft.	
GRAVEL PACK INTERVALS: From <u>140</u> ft. to <u>157</u> ft., From ft. to ft.	
From ft. to ft., From ft. to ft.	
6 GROUT MATERIAL: 1 <u>Neat cement</u> 2 Cement grout 3 Bentonite 4 Other <u>Bentonite Holeplug</u>	
Grout Intervals: From <u>10</u> ft. to <u>137</u> ft., From <u>0</u> ft. to <u>10</u> ft., From <u>137</u> ft. to <u>140</u> ft.	
What is the nearest source of possible contamination:	
1 Septic tank 4 Lateral lines 7 Pit privy 10 Livestock pens 14 Abandoned water well	
2 Sewer lines 5 Cess pool 8 Sewage lagoon 11 Fuel storage 15 Oil well/Gas well	
3 Watertight sewer lines 6 Seepage pit 9 Feedyard 12 Fertilizer storage 16 Other (specify below)	
13 Insecticide storage None known	
Direction from well? How many feet?	
<table border="1" style="width:100%; border-collapse: collapse;"><thead><tr><th>FROM</th><th>TO</th><th>LITHOLOGIC LOG</th><th>FROM</th><th>TO</th><th>PLUGGING INTERVALS</th></tr></thead><tbody><tr><td>0</td><td>6</td><td>Clay, brown, hard, silty</td><td>133</td><td>137</td><td>Clay, tan, hard, silty</td></tr><tr><td>6</td><td>13</td><td>Clay, red, brown, hard, silty</td><td>137</td><td>157</td><td>Sand and gravel, fine, medium, loose, clean</td></tr><tr><td>13</td><td>40</td><td>Clay, tan, silty</td><td></td><td></td><td></td></tr><tr><td>40</td><td>70</td><td>Sand and gravel, fine, medium, thin clay streaks, loose, clean</td><td></td><td></td><td></td></tr><tr><td>70</td><td>87</td><td>Sand and gravel, fine, medium, loose, clean</td><td></td><td></td><td></td></tr><tr><td>87</td><td>91</td><td>Clay, yellow, black, hard, silty</td><td></td><td></td><td></td></tr><tr><td>91</td><td>96.5</td><td>Sand and gravel, fine, medium, loose, clean</td><td></td><td></td><td></td></tr><tr><td>96.5</td><td>116</td><td>Clay, gray, hard, silty</td><td></td><td></td><td></td></tr><tr><td>116</td><td>121</td><td>Sand and gravel, fine, medium, loose, clean</td><td></td><td></td><td></td></tr><tr><td>121</td><td>133</td><td>Sand and gravel, fine, medium, loose, clean</td><td></td><td></td><td></td></tr>
7 CONTRACTOR'S OR LANDOWNER'S CERTIFICATION: This water well was (1) <u>constructed</u> , (2) reconstructed, or (3) plugged under my jurisdiction and was completed on (mo/day/year) <u>12-19-94</u> and this record is true to the best of my knowledge and belief. Kansas	
Water Well Contractor's License No. <u>185</u> This Water Well Record was completed on (mo/day/yr) <u>1-3-95</u>	
under the business name of <u>Clarke Well & Equipment, Inc.</u> by (signature) <u>Clarke Well & Equipment, Inc.</u>	