

CORRECTION(S) TO WATER WELL RECORD (WWC-5)

(to rectify lacking or incorrect information)

County: Harvey

Location listed as:

Section-Township-Range: 18-22 S-3 W

Fraction ($\frac{1}{4}$ $\frac{1}{4}$ $\frac{1}{4}$): NW NW NW

Location changed to:

18-22 S-3 W

NW NW SW

Other changes: Initial statements: _____

Changed to: _____

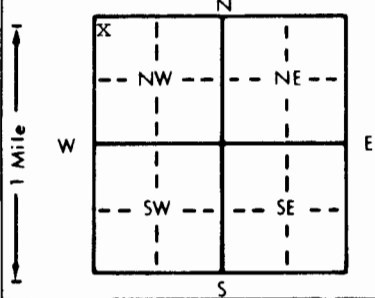
Comments: Latitude: 38.13678° N., Longitude: 97.700975 W.,
from GPS coordinates listed in KGS WIZARD database.

verification method: Latitude & longitude, and information in
KGS WIZARD database.

initials: WRJ date: 7/3/2006

submitted by: Kansas Geological Survey, Data Resources Library, 1930 Constant Ave., Lawrence, KS 66047-3726

to: Kansas Dept of Health & Environment, Bureau of Water, 1000 SW Jackson, Suite 420, Topeka, KS 66612-1367.

1 LOCATION OF WATER WELL:		Fraction	Section Number		Township Number		Range Number	
County: Harvey		NW 1/4 NW 1/4 NW 1/4	18		T 22 S		R 3 E/W	
Distance and direction from nearest town or city street address of well if located within city?								
Approximately 8 miles north and 2 miles west of Burrton								
2 WATER WELL OWNER:		Equus Beds Ground Water Management District #2						
RR#, St. Address, Box # :		313 Spruce		Board of Agriculture, Division of Water Resources				
City, State, ZIP Code :		Halstead, KS 67056-1925		Application Number:				
3 LOCATE WELL'S LOCATION WITH AN "X" IN SECTION BOX:		4 DEPTH OF COMPLETED WELL: 145 ft. ELEVATION: unknown						
		Depth(s) Groundwater Encountered 1. ft. 2. ft. 3. ft.						
		WELL'S STATIC WATER LEVEL 22.62 ft. below land surface measured on mo/day/yr 11-30-94						
		Pump test data: Well water was not ch'd ft. after hours pumping gpm						
		Est. Yield unknown gpm: Well water was ft. after hours pumping gpm						
		Bore Hole Diameter 6 1/2 in. to 145 ft., and in. to ft.						
		WELL WATER TO BE USED AS:						
		5 Public water supply 8 Air conditioning 11 Injection well						
		1 Domestic 3 Feedlot 6 Oil field water supply 9 Dewatering 12 Other (Specify below)						
		2 Irrigation 4 Industrial 7 Lawn and garden only 10 Monitoring well Observation Well						
		Was a chemical/bacteriological sample submitted to Department? Yes No X If yes, mo/day/yr sample was submitted						
		Water Well Disinfected? Yes No X						
5 TYPE OF BLANK CASING USED:		CASING JOINTS: Glued X Clamped						
1 Steel 3 RMP (SR) 5 Wrought iron 8 Concrete tile		Welded						
2 PVC 4 ABS 6 Asbestos-Cement 9 Other (specify below)		Threaded slip x thread						
Blank casing diameter steel 2 in. to 7 ft. Dia. PVC 2 in. to 132 ft. Dia								
Casing height above land surface 36 in., weight steel 3.65/PVC .70 lbs./ft. Wall thickness or gauge No. 154								
TYPE OF SCREEN OR PERFORATION MATERIAL:		7 PVC 10 Asbestos-cement						
1 Steel 3 Stainless steel 5 Fiberglass 8 RMP (SR) 11 Other (specify)								
2 Brass 4 Galvanized steel 6 Concrete tile 9 ABS 12 None used (open hole)								
SCREEN OR PERFORATION OPENINGS ARE:		5 Gauzed wrapped 8 Saw cut 11 None (open hole)						
1 Continuous slot 3 Mill slot 6 Wire wrapped 9 Drilled holes								
2 Louvered shutter 4 Key punched 7 Torch cut 10 Other (specify)								
SCREEN-PERFORATED INTERVALS:		From 132 ft. to 142 ft. From ft. to ft.						
GRAVEL PACK INTERVALS:		From 127 ft. to 145 ft. From ft. to ft.						
6 GROUT MATERIAL:		Bentonite Holeplug						
1 Neat cement 2 Cement grout 3 Bentonite 4 Other								
Grout Intervals: From 17 ft. to 124 ft. From 0 ft. to 17 ft. From 124 ft. to 127 ft.								
What is the nearest source of possible contamination:		10 Livestock pens 14 Abandoned water well						
1 Septic tank 4 Lateral lines 7 Pit privy 11 Fuel storage 15 Oil well/Gas well								
2 Sewer lines 5 Cess pool 8 Sewage lagoon 12 Fertilizer storage 16 Other (specify below)								
3 Watertight sewer lines 6 Seepage pit 9 Feedyard 13 Insecticide storage None known								
Direction from well?		How many feet?						
FROM	TO	LITHOLOGIC LOG		FROM	TO	PLUGGING INTERVALS		
0	4	Topsoil						
4	32	Clay, tan, caliche, hard, silty						
32	51	Clay, gray, hard, silty						
51	53	Sand, very fine, fine, loose, clean						
53	64	Clay, black, thin sand streaks						
64	94	Sand and gravel, fine, medium, loose, clean						
94	100	Clay, gray, thin sand streaks, hard, silty						
100	132	Sand and gravel, fine, medium, loose, clean						
132	145	Clay, tan, hard, silty						
7 CONTRACTOR'S OR LANDOWNER'S CERTIFICATION: This water well was (1) constructed, (2) reconstructed, or (3) plugged under my jurisdiction and was completed on (mo/day/year) 12-20-94 and this record is true to the best of my knowledge and belief. Kansas Water Well Contractor's License No. 185 This Water Well Record was completed on (mo/day/yr) 1-3-95 under the business name of Clarke Well & Equipment, Inc. by (signature) [Signature]								
INSTRUCTIONS: Use typewriter or ball point pen. PLEASE PRESS FIRMLY and PRINT clearly. Please fill in blanks, underline or circle the correct answers. Send top three copies to Kansas Department of Health and Environment, Bureau of Water, Topeka, Kansas 66620-0001. Telephone: 913-296-5545. Send one to WATER WELL OWNER and retain one for your records.								