

WATER WELL RECORD Form WWC-5

36-225-31W

Original Record Correction Change in Well Use


Division of Water Resources App. No.

13326

Well ID

1 LOCATION OF WATER WELL: County: Finney Fraction SWSE Section Number 3336 Township Number T 22 S Range Number R 30 E W

2 WELL OWNER: Last Name: KOSTER TRU First: DUANE E 8 Street or Rural Address where well is located (if unknown, distance and direction from nearest town or intersection): 1 MILE NORTH FROM INTERSECTION OF E 7 MILE RD & N. MENNONITE RD, WEST INTO FIELD 2450 FT.

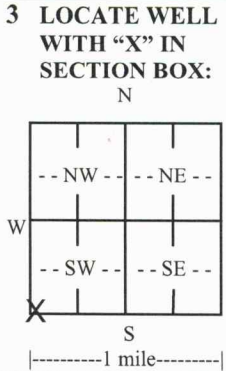

3 LOCATE WELL WITH 'X' IN SECTION BOX: 4 DEPTH OF COMPLETED WELL: 263 ft. Depth(s) Groundwater Encountered: 1) 106 ft. 2) ... 3) ... 4) Dry Well

5 Latitude: 38.089832 (decimal degrees) Longitude: 100.67266 (decimal degrees) Datum: WGS 84 NAD 83 NAD 27

7 WELL WATER TO BE USED AS: 1. Domestic: Household, Lawn & Garden, Livestock, Irrigation, Feedlot, Industrial, Public Water Supply, Dewatering, Aquifer Recharge, Monitoring, Environmental Remediation, Air Sparge, Soil Vapor Extraction, Recovery, Injection, Oil Field Water Supply, Test Hole, Geothermal, Closed Loop, Open Loop, Surface Discharge, Inj. of Water, Other (specify)

Was a chemical/bacteriological sample submitted to KDHE? Yes No If yes, date sample was submitted: Water well disinfected? Yes No

8 TYPE OF CASING USED: Steel PVC Other CASING JOINTS: Glued Clamped Welded Threaded Casing diameter 16 in. to 263 ft., Diameter in. to ft., Diameter in. to ft., Casing height above land surface 24 in. Weight lbs./ft. Wall thickness or gauge No. 250

TYPE OF SCREEN OR PERFORATION MATERIAL: Steel Stainless Steel Brass Galvanized Steel PVC Other (Specify) SCREEN OR PERFORATION OPENINGS ARE: Continuous Slot Mill Slot Gauze Wrapped Torch Cut Drilled Holes Other (Specify) Louvered Shutter Key Punched Wire Wrapped Saw Cut None (Open Hole)

SCREEN-PERFORATED INTERVALS: From 93 ft. to 253 ft., From ... ft. to ... ft., From ... ft. to ... ft. GRAVEL PACK INTERVALS: From 20 ft. to 263 ft., From ... ft. to ... ft., From ... ft. to ... ft.

9 GROUT MATERIAL: Neat cement Cement grout Bentonite Other Grout Intervals: From 0 ft. to 20 ft., From ... ft. to ... ft., From ... ft. to ... ft. Nearest source of possible contamination: No potential source of contamination within 200 ft. Septic Tank Lateral Lines Pit Privy Livestock Pens Insecticide Storage Sewer Lines Cess Pool Sewage Lagoon Fuel Storage Abandoned Water Well Watertight Sewer Lines Seepage Pit Feedyard Fertilizer Storage Oil Well/Gas Well Other (Specify)

Table with columns: 10 FROM, TO, LITHOLOGIC LOG, FROM, TO, LITHO. LOG (cont.) or PLUGGING INTERVALS. Rows include TOPSOIL, CLAY, CEM. SAND & M/C SAND & F. TR. MED, SANDY CLAY & MED SAND, F/M GRAVEL, M/C SAND & CEM SAND, SANDY CLAY, M/C SAND & TR. F. GRAVEL, SANDY CLAY, TR. M/C SAND, F/TR MED. GRAVEL, M/C SAND & TR. C

11 CONTRACTOR'S OR LANDOWNER'S CERTIFICATION: This water well was constructed, reconstructed, or plugged under my jurisdiction and was completed on (mo-day-year) 01/15/2020 and this record is true to the best of my knowledge and belief. Kansas Water Well Contractor's License No. 748 This Water Well Record was completed on (mo-day-year) 02/19/2020 under the business name of Downey Drilling, Inc.