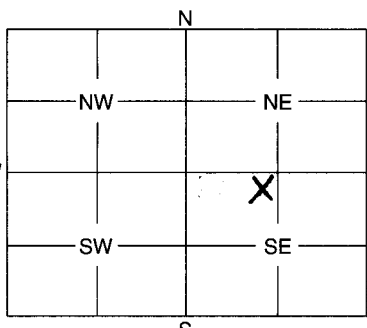


1 LOCATION OF WATER WELL: County: <u>Finney</u>	Fraction <u>NE NW SE</u> <u>¼ ¼ ¼</u>	Section Number <u>16</u>	Township Number <u>22</u>	Range Number <u>32</u> <span style="float:right; border: 1px solid black; border-radius: 50%; padding: 2px;">EW</span>
--	---	-----------------------------	------------------------------	---

Distance and direction from nearest town or city street address of well if located within city?

2 WATER WELL OWNER: RR #, St. Address, Box #: City, State, ZIP Code :	<u>Helen Batchelder</u> <u>1850 Jennie Barker Rd.</u> <u>Garden City, KS 67846</u>	Board of Agriculture, Division of Water Resources Application Number:
---	--	--

3 MARK WELL'S LOCATION WITH AN "X" IN SECTION BOX:  <div style="text-align: center;">  </div>	4 DEPTH OF WELL ..... <u>211</u> ..... ft. WELL'S STATIC WATER LEVEL ..... <u>147</u> ..... ft. WELL WAS USED AS: <table style="width:100%; border: none;"> <tr> <td><input checked="" type="checkbox"/> Domestic</td> <td>5 Public Water Supply</td> <td>9 Dewatering</td> </tr> <tr> <td>2 Irrigation</td> <td>6 Oil Field Water Supply</td> <td>10 Monitoring Well</td> </tr> <tr> <td>3 Feedlot</td> <td>7 Domestic (Lawn &amp; Garden)</td> <td>11 Injection Well</td> </tr> <tr> <td>4 Industrial</td> <td>8 Air Conditioning</td> <td>12 Other .....</td> </tr> </table> <p>Was a chemical / bacteriological sample submitted to Department? Yes ..... No <input checked="" type="checkbox"/> .....</p> <p>If yes, mo/day/yr sample was submitted .....</p> <p>Water Well Disinfected: Yes <input checked="" type="checkbox"/> ..... No .....</p>	<input checked="" type="checkbox"/> Domestic	5 Public Water Supply	9 Dewatering	2 Irrigation	6 Oil Field Water Supply	10 Monitoring Well	3 Feedlot	7 Domestic (Lawn & Garden)	11 Injection Well	4 Industrial	8 Air Conditioning	12 Other .....
<input checked="" type="checkbox"/> Domestic	5 Public Water Supply	9 Dewatering											
2 Irrigation	6 Oil Field Water Supply	10 Monitoring Well											
3 Feedlot	7 Domestic (Lawn & Garden)	11 Injection Well											
4 Industrial	8 Air Conditioning	12 Other .....											

5 TYPE OF BLANK CASING USED:	<table style="width:100%; border: none;"> <tr> <td>1 Steel</td> <td>3 RMP (SR)</td> <td>5 Wrought</td> <td>7 Fiberglass</td> <td>9 Other (Specify below)</td> </tr> <tr> <td><input checked="" type="checkbox"/> PVC</td> <td>4 ABS</td> <td>6 Asbestos-Cement</td> <td>8 Concrete Tile</td> <td>.....</td> </tr> </table>	1 Steel	3 RMP (SR)	5 Wrought	7 Fiberglass	9 Other (Specify below)	<input checked="" type="checkbox"/> PVC	4 ABS	6 Asbestos-Cement	8 Concrete Tile	.....
1 Steel	3 RMP (SR)	5 Wrought	7 Fiberglass	9 Other (Specify below)							
<input checked="" type="checkbox"/> PVC	4 ABS	6 Asbestos-Cement	8 Concrete Tile	.....							
Blank casing diameter ..... <u>5</u> ..... in.	Was casing pulled? Yes ..... No ..... If yes, how much .....										
Casing height above or below land surface ..... <u>5'</u> ..... in.											

6 GROUT PLUG MATERIAL:	<table style="width:100%; border: none;"> <tr> <td>1 Neat cement</td> <td>2 Cement grout</td> <td><input checked="" type="checkbox"/> Bentonite</td> <td>4 Other .....</td> </tr> </table>	1 Neat cement	2 Cement grout	<input checked="" type="checkbox"/> Bentonite	4 Other .....																
1 Neat cement	2 Cement grout	<input checked="" type="checkbox"/> Bentonite	4 Other .....																		
Grout Plug Intervals:	From ..... <u>5</u> ..... ft. to ..... <u>20</u> ..... ft., From ..... ft. to ..... ft., From ..... to ..... ft.																				
What is the nearest source of possible contamination:																					
<table style="width:100%; border: none;"> <tr> <td><input checked="" type="checkbox"/> Septic tank</td> <td>6 Seepage pit</td> <td>11 Fuel storage</td> <td>16 Other (specify below)</td> </tr> <tr> <td>2 Sewer lines</td> <td>7 Pit privy</td> <td>12 Fertilizer storage</td> <td>.....</td> </tr> <tr> <td>3 Watertight sewer lines</td> <td>8 Sewage lagoon</td> <td>13 Insecticide storage</td> <td></td> </tr> <tr> <td>4 Lateral lines</td> <td>9 Feedyard</td> <td>14 Abandoned water well</td> <td></td> </tr> <tr> <td>5 Cess pool</td> <td>10 Livestock pens</td> <td>15 Oil well/Gas well</td> <td></td> </tr> </table>	<input checked="" type="checkbox"/> Septic tank	6 Seepage pit	11 Fuel storage	16 Other (specify below)	2 Sewer lines	7 Pit privy	12 Fertilizer storage	.....	3 Watertight sewer lines	8 Sewage lagoon	13 Insecticide storage		4 Lateral lines	9 Feedyard	14 Abandoned water well		5 Cess pool	10 Livestock pens	15 Oil well/Gas well		Direction from well? ..... How many feet? ..... <u>100</u> .....
<input checked="" type="checkbox"/> Septic tank	6 Seepage pit	11 Fuel storage	16 Other (specify below)																		
2 Sewer lines	7 Pit privy	12 Fertilizer storage	.....																		
3 Watertight sewer lines	8 Sewage lagoon	13 Insecticide storage																			
4 Lateral lines	9 Feedyard	14 Abandoned water well																			
5 Cess pool	10 Livestock pens	15 Oil well/Gas well																			

FROM	TO	PLUGGING MATERIALS
147	211	<u>¾ yds. washed sand + gravel</u>
20	147	<u>1½ yds fill sand, clay + bentonite</u>
5	20	<u>150 lbs bentonite</u>
0	5	<u>top soil</u>

7 CONTRACTOR'S OF LANDOWNER'S CERTIFICATION:	This water well was plugged under my jurisdiction and was completed on (mo/day/year) ..... <u>6-7-06</u> ..... and this record is true to the best of my knowledge and belief. Kansas Water Well Contractor's License No. .... <u>532</u> ..... This Water Well Record was completed on (mo/day/year) ..... <u>6-16-06</u> ..... under the business name of ..... <u>Midwest Well &amp; Pump Inc.</u> ..... by (signature) <u>Kurt Sauer</u> .....
--	--

INSTRUCTIONS: Use typewriter or ball point pen. Please press firmly and print clearly. Please fill in blanks, underline or circle the correct answers. Send top three copies to Kansas Department of Health and Environment, Bureau of Water, Geology Section, 1000 SW Jackson St., Ste. 420, Topeka, Kansas 66612-1367. Telephone: 785/296-5522. Send one to Water Well Owner and retain one for your records.