


1 LOCATION OF WATER WELL: Fraction $\frac{1}{4}$ $\frac{1}{4}$ SW $\frac{1}{4}$ Section Number 27 Township Number T 22 S Range Number R 32 EW

Distance and direction from nearest town or city street address of well if located within city?
 9 miles N. 156 on Jennie Barber Rd East Side

2 WATER WELL OWNER: J. Will Poyntad
 RR#, St. Address, Box #: 3866 Quartershorse Rd.
 City, State, ZIP Code: Garden City KS 67853
 Board of Agriculture, Division of Water Resources
 Application Number:

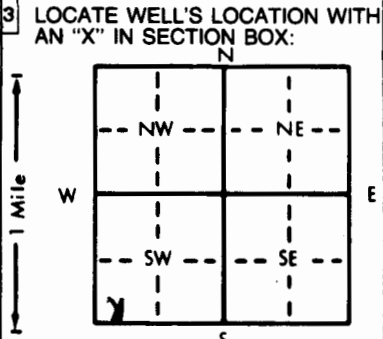

4 DEPTH OF COMPLETED WELL: 216 ft. ELEVATION:
 Depth(s) Groundwater Encountered 1. ft. 2. ft. 3. ft.
 WELL'S STATIC WATER LEVEL: 178 ft. below land surface measured on mo/day/yr 4-20-04
 Pump test data: Well water was ft. after hours pumping gpm
 Est. Yield gpm: Well water was ft. after hours pumping gpm
 Bore Hole Diameter: 9 7/8 in. to 2 1/6 ft. and in. to ft.
 WELL WATER TO BE USED AS:
 Domestic 3 Feedlot 6 Oil field water supply 9 Dewatering 12 Other (Specify below)
 2 Irrigation 4 Industrial 7 Lawn and garden only 10 Monitoring well
 Was a chemical/bacteriological sample submitted to Department? Yes No ; If yes, mo/day/yr sample was submitted
 Water Well Disinfected? Yes No

5 TYPE OF BLANK CASING USED:
 1 Steel 3 RMP (SR) 5 Wrought iron 8 Concrete tile CASING JOINTS: Glued Clamped
 2 PVC 4 ABS 6 Asbestos-Cement 9 Other (specify below) Welded
 7 Fiberglass Threaded
 Blank casing diameter 5 in. to ft. Dia. in. to ft. Dia. in. to ft.
 Casing height above land surface 12 in., weight 200 lbs./ft. Wall thickness or gauge No.
 TYPE OF SCREEN OR PERFORATION MATERIAL:
 1 Steel 3 Stainless steel 5 Fiberglass 8 RMP (SR) 10 Asbestos-cement
 2 Brass 4 Galvanized steel 6 Concrete tile 9 ABS 12 None used (open hole)
 SCREEN OR PERFORATION OPENINGS ARE:
 1 Continuous slot 3 Mill slot 5 Gauzed wrapped 8 Saw cut 11 None (open hole)
 2 Louvered shutter 4 Key punched 6 Wire wrapped 9 Drilled holes
 7 Torch cut 10 Other (specify)
 SCREEN-PERFORATED INTERVALS: From 167 ft. to 216 ft. From ft. to ft.
 GRAVEL PACK INTERVALS: From 167 ft. to 216 ft. From ft. to ft.
 From 25 ft. to 147 ft. From ft. to ft.

6 GROUT MATERIAL: 1 Neat cement 2 Cement grout 3 Bentonite 4 Other
 Grout Intervals: From 147 ft. to 167 ft. From 5 ft. to 25 ft. From ft. to ft.
 What is the nearest source of possible contamination:
 1 Septic tank 4 Lateral lines 7 Pit privy 10 Livestock pens 14 Abandoned water well
 2 Sewer lines 5 Cess pool 8 Sewage lagoon 11 Fuel storage 15 Oil well/Gas well
 3 Watertight sewer lines 6 Seepage pit 9 Feedyard 12 Fertilizer storage 16 Other (specify below)
 13 Insecticide storage
 Direction from well? How many feet? 500 Ft South

| FROM | TO | LITHOLOGIC LOG | FROM | TO | PLUGGING INTERVALS |
|------|-----|---------------------------------|------|----|--------------------|
| 8 | 8 | Top Soil | | | |
| 8 | 80 | Brown Sandy Clay (Drilled Hard) | | | |
| 80 | 99 | White Clay | | | |
| 99 | 105 | Hard Rock | | | |
| 105 | 109 | Fine to med Sand & gravel | | | |
| 109 | 111 | Hard Rock | | | |
| 111 | 138 | Brown Sandy Clay | | | |
| 138 | 177 | Fine to med Sand & gravel | | | |
| 177 | 200 | Brown Clay | | | |
| 200 | 215 | Fine to med Sand | | | |
| 215 | 220 | Rock | | | |

7 CONTRACTOR'S OR LANDOWNER'S CERTIFICATION: This water well was constructed, (2) reconstructed, or (3) plugged under my jurisdiction and was completed on (mo/day/year) 5-8-04 and this record is true to the best of my knowledge and belief. Kansas Water Well Contractor's License No. 172 This Water Well Record was completed on (mo/day/yr) 5-8-04 under the business name of Jonagan Drilling by signature [Signature]

OFFICE USE ONLY
T
R
EW
SEC.