


1 LOCATION OF WATER WELL: County: Finney Fraction: $\frac{1}{4}$ $\frac{1}{4}$ SE $\frac{1}{4}$ Section Number: 36 Township Number: T 22 S Range Number: R 33 E/W

Distance and direction from nearest town or city street address of well if located within city? 7 1/2 m N Hwy 83 Garden City

2 WATER WELL OWNER: RR#, St. Address, Box #: Ken Parks 1555 Northshore Circle Garden City KS 67846 Board of Agriculture, Division of Water Resources City, State, ZIP Code: 67846 Application Number:

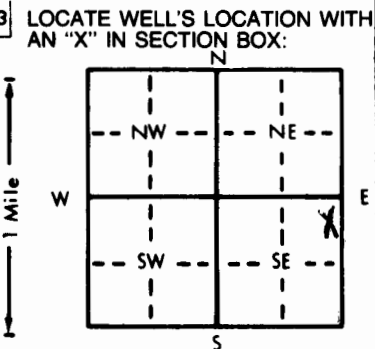

4 DEPTH OF COMPLETED WELL: 203 ft. ELEVATION: _____ ft.

Depth(s) Groundwater Encountered 1. _____ ft. 2. _____ ft. 3. _____ ft.

WELL'S STATIC WATER LEVEL: 117 ft. below land surface measured on mo/day/yr 6-21-01

Pump test data: Well water was _____ ft. after _____ hours pumping _____ gpm

Est. Yield _____ gpm: Well water was _____ ft. after _____ hours pumping _____ gpm

Bore Hole Diameter: 9 7/8 in. to 2.55 ft., and _____ in. to _____ ft.

WELL WATER TO BE USED AS: 5 Public water supply 8 Air conditioning 11 Injection well
 Domestic 3 Feedlot 6 Oil field water supply 9 Dewatering 12 Other (Specify below)
 2 Irrigation 4 Industrial 7 Lawn and garden only 10 Monitoring well

Was a chemical/bacteriological sample submitted to Department? Yes _____ No ; If yes, mo/day/yr sample was submitted _____

Water Well Disinfected? Yes _____ No _____

5 TYPE OF BLANK CASING USED:

1 Steel	3 RMP (SR)	5 Wrought iron	8 Concrete tile	CASING JOINTS: Glued <input checked="" type="checkbox"/> Clamped _____
<input checked="" type="checkbox"/> PVC	4 ABS	6 Asbestos-Cement	9 Other (specify below)	Welded _____
		7 Fiberglass		Threaded _____

Blank casing diameter: 5 in. to 1.80 ft., Dia _____ in. to _____ ft., Dia _____ in. to _____ ft.

Casing height above land surface: 1.2 in., weight 200 lbs./ft. Wall thickness or gauge No. _____

TYPE OF SCREEN OR PERFORATION MATERIAL: PVC 10 Asbestos-cement

1 Steel	3 Stainless steel	5 Fiberglass	8 RMP (SR)	11 Other (specify) _____
2 Brass	4 Galvanized steel	6 Concrete tile	9 ABS	12 None used (open hole)

SCREEN OR PERFORATION OPENINGS ARE:

1 Continuous slot	<input checked="" type="checkbox"/> Mill slot	5 Gauzed wrapped	8 Saw cut	11 None (open hole)
2 Louvered shutter	4 Key punched	6 Wire wrapped	9 Drilled holes	
		7 Torch cut	10 Other (specify) _____	

SCREEN-PERFORATED INTERVALS: From 1.80 ft. to 203 ft., From _____ ft. to _____ ft.

GRAVEL PACK INTERVALS: From 1.80 ft. to 203 ft., From _____ ft. to _____ ft.

From 40 ft. to 160 ft., From _____ ft. to _____ ft.

6 GROUT MATERIAL: 1 Neat cement 2 Cement grout Bentonite 4 Other _____

Grout Intervals: From 160 ft. to 180 ft., From 5 ft. to 40 ft., From _____ ft. to _____ ft.

What is the nearest source of possible contamination:

1 Septic tank	4 Lateral lines	7 Pit privy	10 Livestock pens	14 Abandoned water well
2 Sewer lines	5 Cess pool	8 Sewage lagoon	11 Fuel storage	15 Oil well/Gas well
3 Watertight sewer lines	6 Seepage pit	9 Feedyard	12 Fertilizer storage	16 Other (specify below)
			13 Insecticide storage	<u>10T</u>

Direction from well? _____ How many feet? _____

FROM	TO	LITHOLOGIC LOG	FROM	TO	PLUGGING INTERVALS
0	7	Top Soil			
7	30	Brown Sandy clay			
30	32	Blue clay			
32	46	Fine to med Sand & gravel			
46	92	Brown Sandy clay			
92	97	Fine to med sand Hard Rock			
97	131	Brown Sandy clay			
131	150	Fine to med Sand & gravel			
150	160	Brown clay			
160	167	Fine to med Sand & gravel			
167	168	Hard Rock			
168	185	Fine to med Sand			
185	190	Brown clay Sandy			
190	203	Fine to med Sand & gravel			
203	255	yellow clay - fine Sand			

7 CONTRACTOR'S OR LANDOWNER'S CERTIFICATION: This water well was constructed, reconstructed, or plugged under my jurisdiction and was completed on (mo/day/year) 6-28-01 and this record is true to the best of my knowledge and belief. Kansas Water Well Contractor's License No. 172 This Water Well Record was completed on (mo/day/yr) 7-21-01 under the business name of Jonagan Drilling by (signature) mej

OFFICE USE ONLY T R E/W SEC.