


1 LOCATION OF WATER WELL: Fraction Section Number Township Number Range Number
 COUNTY: 028 FINNEY NW 1/4 SW 1/4 NW 1/4 8 T 22 S R 34 W

Distance and direction from nearest town or city street address of well if located within city?
 APPROX. 5 MILES WEST AND 10 3/4 NORTH OF HOLCOMB

2 WATER WELL OWNER: ENGLER FARMS INC Board of Agriculture, Division of Water Resources
 RR#, St. Address, Box #: RT 1 BOX 350 Application Number:
 City, State, ZIP code: DEERFIELD, KS 67838-9522

3 LOCATE WELL'S LOCATION WITH AN "X" IN SECTION BOX:

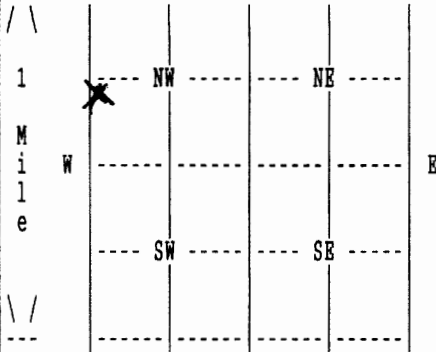

4 DEPTH OF COMPLETED WELL 176 ELEVATION: 0
 Depth(s) Groundwater Encountered 1. 0 ft. 2. 0 ft. 3. 0 ft.

WELL'S STATIC WATER LEVEL 0 ft. below land surface measured on mo/day/yr
 Pump test data: Well water was 0 ft. after 0 hours pumping 0 gpm

Estimated Yield 0 gpm: Well water was 0 ft. after 0 hours pumping 0 gpm

Bore Hole Diameter in. to 0 ft., and in. to 0 ft.

WELL WATER WAS: 02 IRRIGATION

Was a chemical/bacteriological sample submitted to department? No;
 If yes, mo/day/yr sample was submitted Water well disinfected? Yes

5 TYPE OF BLANK CASING USED: 01 STEEL CASING JOINTS: WELDED
 Blank casing diameter 16 in. to 176 ft., Dia in. to 0 ft., Dia in. to 0 ft.
 Casing height above land surface -48 in., weight 0 lbs/ft. Wall thickness or gauge No.
 TYPE OF SCREEN OR PERFORATION MATERIAL: 01 STEEL
 SCREEN OR PERFORATION OPENINGS ARE: CT TORCH CUT

SCREEN PERFORATED INTERVALS: From 116 ft. to 156 ft., From 0 ft. to 0 ft.
 From 156 ft. to 176 ft., From 0 ft. to 0 ft.
 GRAVEL PACK INTERVALS: From 0 ft. to 0 ft., From 0 ft. to 0 ft.
 From 0 ft. to 0 ft., From 0 ft. to 0 ft.

6 GROUT MATERIAL 02 CEMENT GROUT
 Grout Intervals: From 5 ft. to 18 ft., From 0 ft. to 0 ft., From 0 ft. to 0 ft.
 What is the nearest source of possible contamination: NONE OBSERVED
 Direction from well? How many feet? 0

FROM	TO	LITHOLOGIC LOG	FROM	TO	PLUGGING INTERVALS
			0	5	BACKFILL
			5	18	CEMENT
			18	100	CLAY
			100	176	SAND
			0	0	
			0	0	
			0	0	
			0	0	
			0	0	
			0	0	

7 CONTRACTOR'S OR LANDOWNER'S CERTIFICATION: This water well was Plugged under my jurisdiction and was completed on (mo/day/year) 12/13/05 and this record is true to the best of my knowledge and belief. Kansas Water Well Contractor's License No. 145 This Water Well Record was completed on (mo/day/yr) 01/23/06 under the business name of HENKLE DRILLING & SUPPLY by (signature) *Greg Reichert*