

WATER WELL PLUGGING RECORD Form WWC-5P

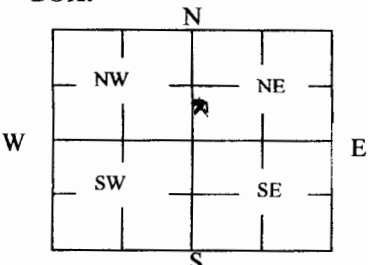
KSA 82a-1212

ID NO.

1 LOCATION OF WATER WELL: County: <u>Finney</u>	Fraction <u>sw 1/4 nw 1/4 sw 1/4 ne 1/4</u>	Section Number <u>30</u>	Township Number <u>T 22 S</u>	Range Number <u>34</u> <input type="checkbox"/> E <input checked="" type="checkbox"/> W
---	--	-----------------------------	----------------------------------	--

Street/Rural Address of Well Location; if unknown, distance & direction from nearest town or intersection: If at owner's address, check here <input type="checkbox"/> <u>Approx. 2,611 ft. west and 1,953 ft south of the miller rd and n byrd intersection</u>	Global Positioning Systems (GPS) information: Latitude: <u>38.114026</u> (in decimal degrees) Longitude: <u>-101.094069</u> (in decimal degrees) Elevation: <u>2990</u> Horizontal Datum: <input checked="" type="checkbox"/> WGS84, <input type="checkbox"/> NAD83, <input type="checkbox"/> NAD27 Collection Method: <input type="checkbox"/> GPS unit (Make/Model: _____) <input checked="" type="checkbox"/> Digital Map/Photo, <input type="checkbox"/> Topographic Map, <input type="checkbox"/> Land Survey Est. Accuracy: <input type="checkbox"/> < 3 m, <input checked="" type="checkbox"/> 3-5 m, <input type="checkbox"/> 5-15 m, <input type="checkbox"/> > 15 m
---	--

2 WATER WELL OWNER: <u>Brian Graham</u> RR#, St. Address, Box #: <u>2150 rd. 220</u> City, State ZIP Code: <u>Deerfield Ks. 67838</u>	
--	--

3 MARK WELL'S LOCATION WITH AN "X" IN SECTION BOX: 	4 DEPTH OF WELL <u>201</u> ft. WELL'S STATIC WATER LEVEL <u>182</u> ft. WELL WAS USED AS: <input checked="" type="checkbox"/> Domestic <input type="checkbox"/> Public Water Supply <input type="checkbox"/> Dewatering <input checked="" type="checkbox"/> Irrigation <input type="checkbox"/> Oil Field Water Supply <input type="checkbox"/> Monitoring <input type="checkbox"/> Feedlot <input type="checkbox"/> Domestic (Lawn & Garden) <input type="checkbox"/> Injection Well <input type="checkbox"/> Industrial <input type="checkbox"/> Air Conditioning <input type="checkbox"/> Other _____ Was a chemical/bacteriological sample submitted to Department? Yes <input type="checkbox"/> No <input checked="" type="checkbox"/>
--	---

5 TYPE OF BLANK CASING USED:

Steel RMP (SR) Wrought Fiberglass Other (Specify below) _____
 PVC ABS Asbestos-Cement Concrete Tile

Blank casing diameter 16 in. Was casing pulled? Yes No If yes, how much 8ft.
 Casing height above or below land surface 12 in.

6 GROUT PLUG MATERIAL: Neat cement Cement grout Bentonite Other _____

Grout Plug Intervals: From 9 ft. to 6 ft., From 6 ft. to 5 ft., From _____ ft. to _____ ft.

What is the nearest source of possible contamination:

<input type="checkbox"/> Septic tank	<input type="checkbox"/> Seepage pit	<input type="checkbox"/> Fuel storage	<input type="checkbox"/> Other (specify below) _____
<input type="checkbox"/> Sewer lines	<input type="checkbox"/> Pit privy	<input type="checkbox"/> Fertilizer storage	
<input type="checkbox"/> Watertight sewer lines	<input type="checkbox"/> Sewage lagoon	<input type="checkbox"/> Insecticide storage	
<input type="checkbox"/> Lateral lines	<input type="checkbox"/> Feedyard	<input type="checkbox"/> Abandoned water well	
<input type="checkbox"/> Cess pool	<input type="checkbox"/> Livestock pens	<input checked="" type="checkbox"/> Oil-well/Gas well	
Direction from well? <u>NW</u>			
How many feet? <u>1,000 ?</u>			

FROM	TO	PLUGGING MATERIALS	FROM	TO	PLUGGING MATERIALS
201 ft.	179 ft.	chlorinated gravel/sand			
179 ft.	9 ft.	silt clay soil inside casing			
9 ft.	6 ft.	bentonite plug inside casing&anular			
6 ft.	5 ft.	bentonite cap diameter of 32inches			
5 ft.	0 ft.	surface soil			

7 CONTRACTOR'S OR LANDOWNER'S CERTIFICATION: This water well was plugged under my jurisdiction and was completed on (mo/day/year) Oct. 18-2018 and this record is true to the best of my knowledge and belief. Kansas Water Well Contractor's License No. 944. This Water Well Record was completed on (mo/day/year) Oct. 20-2018 under the business name of _____ county well plugging by (signature) [Signature]

Send one white copy to Kansas Department of Health & Environment, Geology Section, 1000 SW Jackson Street, Ste. 420, Topeka, KS 66612-1367. Send one copy to WATER WELL OWNER and retain one for your records.
 Visit us at <http://www.kdheks.gov/waterwell/index.html> Telephone 785-296-5524.