


WATER WELL RECORD Form WWC-5 KSA 82a-1212

1 LOCATION OF WATER WELL: Fraction Section Number Township Number Range Number  
 COUNTY: **047 KEARNY** NE 1/4 NE 1/4 NE 1/4 **14** T **22** S R **35** W

Distance and direction from nearest town or city street address of well if located within city?  
**APPROX. 1/2 MILE NORTHEAST & 11 NORTH OF DEERFIELD**

2 WATER WELL OWNER: **ENGLER FARMS INC.** Board of Agriculture, Division of Water Resources  
 RR#, St. Address, Box #: **RT 1 BOX 350**  
 City, State, ZIP code : **DEERFIELD, KS 67838** Application Number:

3 LOCATE WELL'S LOCATION WITH AN "X" IN SECTION BOX:

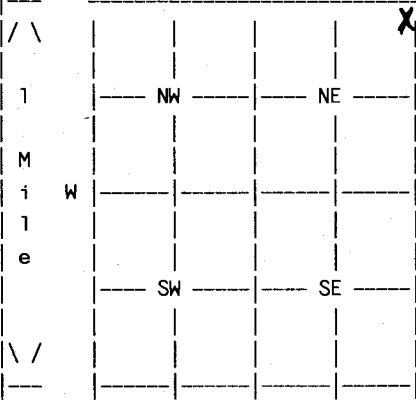

4 DEPTH OF COMPLETED WELL **155** ELEVATION: **0**  
 Depth(s) Groundwater Encountered 1. **0** ft. 2. **0** ft. 3. **0** ft.

WELL'S STATIC WATER LEVEL **105** ft. below land surface measured on mo/day/yr **07/01/98**  
 Pump testdata: Well water was **0** ft. after **0** hours pumping **0** gpm

Estimated Yield **25** gpm: Well water was **0** ft. after **0** hours pumping **0** gpm

Bore Hole Diameter **10** in. to **162** ft., and in. to **0** ft.

WELL WATER TO BE USED AS: **01 DOMESTIC**

Was a chemical/bacteriological sample submitted to department? **No** ;  
 If yes, mo/day/yr sample was submitted Water well disinfected? **Yes**

5 TYPE OF BLANK CASING USED: **02 PVC** CASING JOINTS: **GLUED**  
 Blank casing diameter **5** in. to **155** ft., Dia in. to **0** ft., Dia in. to **0** ft.  
 Casing height above land surface **12** in., weight **3** lbs/ft. Wall thickness or gauge No. **.265**  
 TYPE OF SCREEN OR PERFORATION MATERIAL: **07 PVC**  
 SCREEN OR PERFORATION OPENINGS ARE: **03 MILL SLOT**

SCREEN PERFORATED INTERVALS: From **95** ft. to **155** ft., From **0** ft. to **0** ft.  
 From **0** ft. to **0** ft., From **0** ft. to **0** ft.  
 GRAVEL PACK INTERVALS: From **25** ft. to **155** ft., From **0** ft. to **0** ft.  
 From **0** ft. to **0** ft., From **0** ft. to **0** ft.

6 GROUT MATERIAL **03 BENTONITE**  
 Grout Intervals: From **5** ft. to **25** ft., From **0** ft. to **0** ft., From **0** ft. to **0** ft.  
 What is the nearest source of possible contamination: **14 ABAND. WELL**  
 Direction from well? **WEST**

How many feet? **85**

FROM	TO	LITHOLOGIC LOG	FROM	TO	PLUGGING INTERVALS
0	2	02 SILT			
2	22	01 CLAY 31 CALICHE			
22	56	07 FINE SAND 08 MEDIUM SAND			
56	65	07 FINE SAND 08 MEDIUM SAND 04 SANDY CLAY			
65	90	05 SAND 13 FINE GRAVEL 14 MED GRAVEL			
90	106	01 CLAY			
106	115	05 SAND 28 ROCK			
115	122	01 CLAY 28 ROCK			
122	132	04 SANDY CLAY 05 SAND			
132	138	05 SAND 28 ROCK			

7 CONTRACTOR'S OR LANDOWNER'S CERTIFICATION: This water well was Constructed under my jurisdiction and was completed on (mo/day/year) **07/01/98** and this record is true to the best of my knowledge and belief. Kansas Water Well Contractor's License No. **145** This Water Well Record was completed on (mo/day/yr) **07/23/98** under the business name of **HENKLE DRILLING & SUPPLY** by (signature)

(Continued)

WATER WELL RECORD Form WWC-5 KSA 82a-1212

1 LOCATION OF WATER WELL:	Fraction	Section Number	Township Number	Range Number
COUNTY: <b>047 KEARNY</b>	<b>NE 1/4 NE 1/4 NE 1/4</b>	<b>14</b>	<b>T 22 S</b>	<b>R 35 W</b>

2 WATER WELL OWNER: **ENGLER FARMS INC.**  
RR#, St. Address, Box #: **RT 1 BOX 350** Board of Agriculture, Division of Water Resources

City, State, ZIP code : **DEERFIELD, KS 67838-** Application Number:

FROM	TO	LITHOLOGIC LOG
<b>138</b>	<b>162</b>	<b>01 CLAY 19 SHALE</b>

7 CONTRACTOR'S OR LANDOWNER'S CERTIFICATION: This water well was Constructed under my jurisdiction and was completed on (mo/day/year) **07/01/98** and this record is true to the best of my knowledge and belief. Kansas Water Well Contractor's License No. **145** This Water Well Record was completed on (mo/day/yr) **07/23/98** under the business name of **HENKLE DRILLING & SUPPLY** by (signature) *Bruce Reichert*