


1 LOCATION OF WATER WELL: Fraction NW 1/4 SE 1/4 NE 1/4 Section Number 11 Township Number T 22 S Range Number R 36 E/W

County: Kearny Distance and direction from nearest town or city street address of well if located within city? Approximately 15 miles North & 2 miles East of Lakin, Ks.

2 WATER WELL OWNER: Dick Crump RR#, St. Address, Box # : City, State, ZIP Code : Lakin, Ks. 67860 Board of Agriculture, Division of Water Resources Application Number:

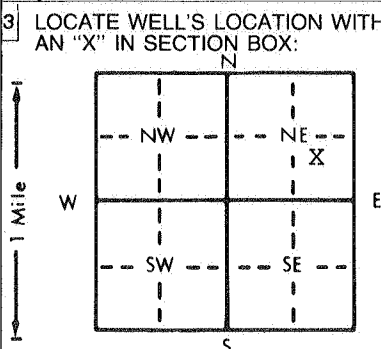

4 DEPTH OF COMPLETED WELL: 160' ft. ELEVATION: WELL'S STATIC WATER LEVEL: 116' ft. below land surface measured on mo/day/yr 4/4/89

Pump test data: Well water was 3 gpm after 11 hours pumping

Bore Hole Diameter: 11 in. to 150 ft.

WELL WATER TO BE USED AS: 5 Public water supply, 8 Air conditioning, 11 Injection well, 12 Other (Specify below)

Was a chemical/bacteriological sample submitted to Department? Yes No X

5 TYPE OF BLANK CASING USED: 1 Steel, 2 PVC, 3 RMP (SR), 4 ABS, 5 Wrought iron, 6 Asbestos-Cement, 7 Fiberglass, 8 Concrete tile, 9 Other (specify below)

Blank casing diameter: 5 in. to 150 ft. Dia. Casing height above land surface: 12 in., weight 2.90 lbs./ft. Wall thickness or gauge No. 26.5W

TYPE OF SCREEN OR PERFORATION MATERIAL: 1 Steel, 2 Brass, 3 Stainless steel, 4 Galvanized steel, 5 Fiberglass, 6 Concrete tile, 7 PVC, 8 RMP (SR), 9 ABS, 10 Asbestos-cement, 11 Other (specify), 12 None used (open hole)

SCREEN OR PERFORATION OPENINGS ARE: 1 Continuous slot, 2 Louvered shutter, 3 Mill slot, 4 Key punched, 5 Gauzed wrapped, 6 Wire wrapped, 7 Torch cut, 8 Saw cut, 9 Drilled holes, 10 Other (specify), 11 None (open hole)

SCREEN-PERFORATED INTERVALS: From 100 ft. to 130 ft.

GRAVEL PACK INTERVALS: From 20 ft. to 150 ft.

6 GROUT MATERIAL: 1 Neat cement, 2 Cement grout, 3 Bentonite, 4 Other

Grout Intervals: From 0 ft. to 20 ft.

What is the nearest source of possible contamination: 1 Septic tank, 2 Sewer lines, 3 Watertight sewer lines, 4 Lateral lines, 5 Cess pool, 6 Seepage pit, 7 Pit privy, 8 Sewage lagoon, 9 Feedyard, 10 Livestock pens, 11 Fuel storage, 12 Fertilizer storage, 13 Insecticide storage, 14 Abandoned water well, 15 Oil well/Gas well, 16 Other (specify below) Water well

Direction from well? Southeast How many feet? 80'

FROM	TO	LITHOLOGIC LOG	FROM	TO	PLUGGING INTERVALS
		See log attached.			

7 CONTRACTOR'S OR LANDOWNER'S CERTIFICATION: This water well was (1) constructed, (2) reconstructed, or (3) plugged under my jurisdiction and was completed on (mo/day/year) 3/31/89 and this record is true to the best of my knowledge and belief. Kansas Water Well Contractor's License No. 145 This Water Well Record was completed on (mo/day/yr) 12/29/89 under the business name of Henkle Drilling & Supply Company, Inc. by (signature) Dick Crump

INSTRUCTIONS: Use typewriter or ball point pen. PLEASE PRESS FIRMLY and PRINT clearly. Please fill in blanks, underline or circle the correct answers. Send top three copies to Kansas Department of Health and Environment, Bureau of Water Protection, Topeka, Kansas 66620-7320. Telephone: 913-296-5514. Send one to WATER WELL OWNER and retain one for your records.

DRILLERS TEST LOG

CUSTOMER'S NAME: Dick Crump DATE: 3/31/89
STREET ADDRESS: TEST # 3 E. LOG Yes
CITY & STATE: Lakin, Ks. 67860 DRILLER Shelden
COUNTY Kearny QUARTER NE SECTION 11 TOWNSHIP 22 RANGE 36
LOCATION 80' Northwest of the old well.

Table with columns: Z, FOOTAGE (From, Pay, TO), DESCRIPTION OF STRATA, WELL LOCATION (STATIC WATER LEVEL, Proposed Well Depth). Rows include soil types like 'Top soil', 'Brown sandy clay', and 'Sand fine to medium coarse'.

GARDEN CITY, KS 67846
3795 West Jones Ave.

HENKLE DRILLING & SUPPLY CO., INC.

316-277-2389

IRRIGATION HEADQUARTERS

TEST HOLES * * * * * IRRIGATION & INDUSTRIAL WELLS * * * * * STOCK WELLS