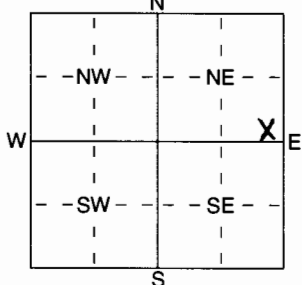


1 LOCATION OF WATER WELL: Fraction JE 1/4 SE 1/4 NE 1/4 Section Number 31 Township Number T 22 S Range Number R 36 E/W
 County: Kearny

Distance and direction from nearest town or city street address of well if located within city?

2 WATER WELL OWNER: Gary Millershaski
 RR#, St. Address, Box # : Box 714 Board of Agriculture, Division of Water Resources
 City, State, ZIP Code : Lakin, KS 67860 Application Number:

3 LOCATE WELL'S LOCATION WITH AN "X" IN SECTION BOX:  4 DEPTH OF COMPLETED WELL 230 ft. ELEVATION:
 Depth(s) Groundwater Encountered 1 ft. 2 ft. 3 ft.
 WELL'S STATIC WATER LEVEL 171 ft. below land surface measured on mo/day/yr 8-18-05
 Pump test data: Well water was ft. after hours pumping gpm
 Est. Yield 30 gpm: Well water was ft. after hours pumping gpm
 WELL WATER TO BE USED AS: 5 Public water supply 8 Air conditioning 11 Injection well
 1 Domestic 3 Feedlot 6 Oil field water supply 9 Dewatering Other (Specify below)
 2 Irrigation 4 Industrial 7 Domestic (lawn & garden) 10 Monitoring well Stock
 Was a chemical/bacteriological sample submitted to Department? Yes No ; If yes, mo/day/yr sample was submitted
 Water Well Disinfected? (Yes) No

5 TYPE OF BLANK CASING USED: 1 Steel 3 RMP (SR) 5 Wrought iron 8 Concrete tile CASING JOINTS: Glued Clamped
 PVC 4 ABS 6 Asbestos-Cement 9 Other (specify below) Welded
 7 Fiberglass Threaded
 Blank casing diameter 10 in. to 230 ft., Dia in. to ft., Dia in. to ft.
 Casing height above land surface 12 in., weight lbs./ft. Wall thickness or gauge No. 200 psi
 TYPE OF SCREEN OR PERFORATION MATERIAL: PVC 10 Asbestos-Cement
 1 Steel 3 Stainless Steel 5 Fiberglass 8 RMP (SR) 11 Other (Specify)
 2 Brass 4 Galvanized Steel 6 Concrete tile 9 ABS 12 None used (open hole)
 SCREEN OR PERFORATION OPENINGS ARE: 5 Gauzed wrapped Saw cut 11 None (open hole)
 1 Continuous slot 3 Mill slot 6 Wire wrapped 9 Drilled holes
 2 Louvered shutter 4 Key punched 7 Torch cut 10 Other (specify) ft.
 SCREEN-PERFORATED INTERVALS: From 200 ft. to 230 ft., From ft. to ft.
 From ft. to ft., From ft. to ft.
 GRAVEL PACK INTERVALS: From 20 ft. to 157 ft., From ft. to ft.
 From 178 ft. to 230 ft., From ft. to ft.

6 GROUT MATERIAL: 1 Neat cement 2 Cement grout Bentonite 4 Other
 Grout Intervals: From 0 ft. to 20 ft., From 157 ft. to 178 ft., From ft. to ft.
 What is the nearest source of possible contamination: Livestock pens 14 Abandoned water well
 1 Septic tank 4 Lateral lines 7 Pit privy 11 Fuel storage 15 Oil well/Gas well
 2 Sewer lines 5 Cess pool 8 Sewage lagoon 12 Fertilizer storage 16 Other (specify below)
 3 Watertight sewer lines 6 Seepage pit 9 Feedyard 13 Insecticide storage
 Direction from well? How many feet? 500

FROM	TO	LITHOLOGIC LOG	FROM	TO	PLUGGING INTERVALS
0	2	top soil	153	160	brown clay, fine sand streaks
2	22	brown clay	160	178	brown clay
22	26	coarse to medium sand, small gravel	178	182	fine sand
26	42	brown clay, cemented sand streaks	182	202	medium to coarse sand, small gravel
42	48	cemented sand	202	203	brown clay, coarse sand, mixed
48	52	brown clay, cemented sand	203	227	med. to coarse sand, broken rock
52	62	medium to coarse sand, small gravel, cemented sand streaks			
62	112	medium to coarse sand, small gravel, loose			
112	118	brown clay	227	229	yellow shale
118	133	medium to coarse sand, loose	229	230	black shale
133	136	cemented sand, brown clay			
136	146	cemented sand, limestone streaks			
146	151	brown clay			
151	153	fine to medium sand			

7 CONTRACTOR'S OR LANDOWNER'S CERTIFICATION: This water well was constructed, (2) reconstructed, or (3) plugged under my jurisdiction and was completed on (mo/day/year) 8-18-05 and this record is true to the best of my knowledge and belief. Kansas Water Well Contractor's Licence No 532 This Water Well Record was completed on (mo/day/yr) 8-25-05 under the business name of Midwest Well & Pump Inc. by (signature) Victor Sankup