

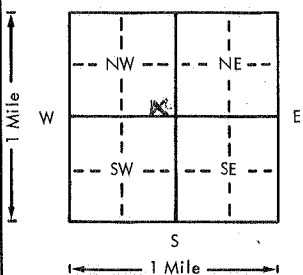
USE TYPEWRITER OR BALL POINT PEN—PRESS FIRMLY, PRINT CLEARLY.

LEOTI 3 NW

WATER WELL RECORD
KSA 82a-1201-1215

Kansas Department of Health and Environment—Division of Environment (Water well Contractors)
Topeka, Kansas 66620

BDD

1. Location of well:		County Kearny	Fraction SE 1/4 SE 1/4 NW 1/4	Section number 18	Township number T 22 S R 37 E 1/4	Range number 37
2. Distance and direction from nearest town or city: Street address of well location if in city:			3. Owner of well: Ray Sonderegger R.R. or street: Rte 2 City, state, zip code: Leoti, Kansas 67861			
4. Locate with "X" in section below: Sketch map: 			6. Bore hole dia. 2 1/4 in. Completion date _____ Well depth 199 ft. 6-12-77			
5. Type and color of material			From	To	7. <input checked="" type="checkbox"/> Cable tool <input checked="" type="checkbox"/> Rotary <input type="checkbox"/> Driven <input type="checkbox"/> Dug <input type="checkbox"/> Hollow rod <input type="checkbox"/> Jetted <input type="checkbox"/> Bored <input type="checkbox"/> Reverse rotary	
					8. Use: <input checked="" type="checkbox"/> Domestic <input type="checkbox"/> Public supply <input type="checkbox"/> Industry <input checked="" type="checkbox"/> Irrigation <input type="checkbox"/> Air conditioning <input type="checkbox"/> Stock <input type="checkbox"/> Lawn <input type="checkbox"/> Oil field water <input type="checkbox"/> Other	
Sandy Clay			0	20	9. Casing: Material Steel Height: Above or below Threaded <input type="checkbox"/> Welded <input checked="" type="checkbox"/> Surface 12 in. RMP _____ PVC _____ Weight 36.86 lbs./ft. Dia. 16 in. to 199 ft. depth Wall Thickness: inches or Dia. _____ in. to _____ ft. depth gage No. 219	
Sand & Gravel			20	140	10. Screens: Manufacturer's name _____ Lakewood Type Millslot Dia. 16" Slot/gauze 1/8 X 2 Length 41 Set between 158 ft. and 199 ft. ft. and _____ ft. Gravel pack? <input checked="" type="checkbox"/> Size range of material 1/4 X 1/2	
Clay, sand & gravel			140	160	11. Static water level: _____ mo./day/yr. 160 ft. below land surface Date 5-6-77	
Sand			160	180	12. Pumping level below land surfaces: 197 ft. after 5 hrs. pumping 240 g.p.m. _____ ft. after _____ hrs. pumping _____ g.p.m. Estimated maximum yield 240 g.p.m.	
Sand & Clay			180	195	13. Water sample submitted: _____ mo./day/yr. Yes <input checked="" type="checkbox"/> No <input type="checkbox"/> Date _____	
Shale			195	199	14. Well head completion: <input type="checkbox"/> Pitless adapter 12 inches above grade	
BROCK 195'					15. Well grouted? <input checked="" type="checkbox"/> Yes With: <input type="checkbox"/> Neat cement <input type="checkbox"/> Bentonite <input checked="" type="checkbox"/> Concrete Depth: From 0 ft. to 10 ft.	
					16. Nearest source of possible contamination: NA ft. _____ Direction _____ Type Field Well disinfected upon completion? _____ Yes <input checked="" type="checkbox"/> No <input type="checkbox"/>	
					17. Pump: _____ Not installed Manufacturer's name Worthington Model number 6S-10L-22 HP _____ Volts _____ Length of drop pipe 190 ft. capacity 220 g.p.m. Type: <input type="checkbox"/> Submersible <input checked="" type="checkbox"/> Turbine <input type="checkbox"/> Jet <input type="checkbox"/> Reciprocating <input type="checkbox"/> Centrifugal <input type="checkbox"/> Other	
(Use a second sheet if needed)					20. Water well contractor's certification: This well was drilled under my jurisdiction and this report is true to the best of my knowledge and belief. High Plains Drilling & Supply, Inc. 136A Business name _____ License No. _____ Address 102 N 3rd Signed B. D. Harbner Date 6-25-77 Authorized representative	
18. Elevation:		19. Remarks: 3308 (TOPO)				
Topography: <input type="checkbox"/> Hill <input checked="" type="checkbox"/> Slope <input type="checkbox"/> Upland <input type="checkbox"/> Valley						

T 22 S R 37 E 1/4 SE SE NW