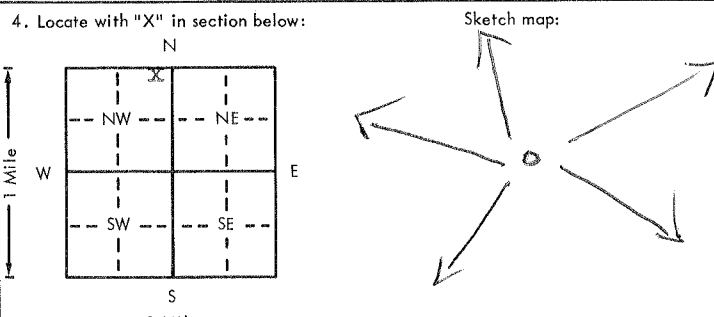


USE TYPEWRITER OR BALL POINT PEN-PRESS FIRMLY, PRINT CLEARLY.

WATER WELL RECORD
KSA 82a-1201-1215

Kansas Department of Health and Environment-Division of Environment
(Water well Contractors)
Topeka, Kansas 66620

1. Location of well:	County Kearny	Fraction NE 1/4 NE 1/4 NW 1/4	Section number 3	Township number T 22 S R	Range number 38 E/W
2. Distance and direction from nearest town or city: 12 mi west, 16 mi north of Lakin, Ks. Street address of well location if in city:			3. Owner of well: Ralph A. Gropp R.R. or street: RFD Lakin, Ks. 67860 City, state, zip code:		
4. Locate with "X" in section below: 			6. Bore hole dia. 7 3/4 in. Completion date Well depth 160 ft. 5-16/78		
5. Type and color of material			7. <input type="checkbox"/> Cable tool <input checked="" type="checkbox"/> Rotary <input type="checkbox"/> Driven <input type="checkbox"/> Dug <input type="checkbox"/> Hollow rod <input type="checkbox"/> Jetted <input type="checkbox"/> Bored <input type="checkbox"/> Reverse rotary		
			8. Use: <input type="checkbox"/> Domestic <input type="checkbox"/> Public supply <input type="checkbox"/> Industry <input type="checkbox"/> Irrigation <input type="checkbox"/> Air conditioning <input checked="" type="checkbox"/> Stock <input type="checkbox"/> Lawn <input type="checkbox"/> Oil field water <input type="checkbox"/> Other		
From To			9. Casing: Material plc Height: above or below Threaded <input type="checkbox"/> Welded <input checked="" type="checkbox"/> Surface 24 in. RMP <input type="checkbox"/> PVC <input checked="" type="checkbox"/> Weight _____ lbs./ft. Dia. 5" in. to 160 ft. depth Wall Thickness: inches or Dia. _____ in. to _____ ft. depth gage No. sch 40		
			10. Screen: Manufacturer's name Jesse-Lowell Type Plastic Dia. 5" Slot/gauze 1/16 Length 20 Set between 140 ft. and 160 ft. _____ ft. and _____ ft. Gravel pack? yes Size range of material 3/16		
Clay			11. Static water level: _____ mo./day/yr. 90 ft. below land surface Date 11-3-77		
Sand, clay mixed			12. Pumping level below land surfaces: blown _____ ft. after _____ hrs. pumping _____ g.p.m. _____ ft. after _____ hrs. pumping _____ g.p.m. Estimated maximum yield 1 g.p.m.		
Sand			13. Water sample submitted: _____ mo./day/yr. Yes <input type="checkbox"/> No <input checked="" type="checkbox"/> Date _____		
Yellow clay, little sand			14. Well head completion: <input type="checkbox"/> Pitless adapter 24 Inches above grade		
Shale			15. Well grouted? yes With: <input checked="" type="checkbox"/> Neat cement <input type="checkbox"/> Bentonite <input type="checkbox"/> Concrete Depth: From 12 ft. to surface		
(Use a second sheet if needed)			16. Nearest source of possible contamination: none ft. _____ Direction _____ Type _____ Well disinfected upon completion? _____ Yes _____ No		
			17. Pump: _____ Not installed Manufacturer's name used pump Model number _____ HP _____ Volts _____ Length of drop pipe 150 ft. capacity _____ g.p.m. Type: <input checked="" type="checkbox"/> Submersible <input type="checkbox"/> Turbine <input type="checkbox"/> Jet <input type="checkbox"/> Reciprocating <input type="checkbox"/> Centrifugal <input type="checkbox"/> Other		
18. Elevation:	19. Remarks: #1 Stock Well		20. Water well contractor's certification: This well was drilled under my jurisdiction and this report is true to the best of my knowledge and belief. High Plains Drilling & Supply Inc. 136B Business name License No. _____ Address 102 N 3rd Garden City, Ks Signed Arthur B. Ruhlman Date 6-8-78 Authorized representative		

22
 38
 W
 E
 3
 Sec
 1/4
 1/4
 1/4
 1/4
 NE
 NE
 NW
 NW