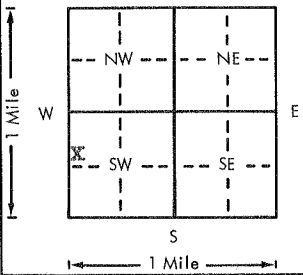


USE TYPEWRITER OR BALL POINT PEN—PRESS FIRMLY, PRINT CLEARLY.

WATER WELL RECORD
KSA 82a-1201-1215

Kansas Department of Health and Environment—Division of Environment
(Water well Contractors)
Topeka, Kansas 66620

1. Location of well:		County Kearny	Fraction SW 1/4 NW 1/4 SW 1/4	Section number 13	Township number T 22	Range number S R 38	XXW
2. Distance and direction from nearest town or city: 10 mi W-12 mi N-1 mi W-1 1/2 mi N of Lakin, Ks. Street address of well location if in city:			3. Owner of well: High Plains Drilling & Supply, Inc. R.R. or street: 5310 W Hwy 50 - RR#1 City, state, zip code: Garden City, Ks. 67846				
4. Locate with "X" in section below: N  W E S 1 Mile			Sketch map:		6. Bore hole dia. 2 1/2 in. Completion date _____ Well depth 225 ft. 1-23-80		
5. Type and color of material			From	To	7. <input type="checkbox"/> Cable tool <input checked="" type="checkbox"/> Rotary <input type="checkbox"/> Driven <input type="checkbox"/> Dug <input type="checkbox"/> Hollow rod <input type="checkbox"/> Jetted <input type="checkbox"/> Bored <input type="checkbox"/> Reverse rotary		
					8. Use: <input type="checkbox"/> Domestic <input type="checkbox"/> Public supply <input type="checkbox"/> Industry <input type="checkbox"/> Irrigation <input type="checkbox"/> Air conditioning <input checked="" type="checkbox"/> Stock <input type="checkbox"/> Lawn <input type="checkbox"/> Oil field water <input type="checkbox"/> Other		
					9. Casing: Material Steel Height <input checked="" type="checkbox"/> Above or below Threaded _____ Welded <input checked="" type="checkbox"/> Surface 12 in. RMP _____ PVC _____ Weight 36.86 lbs./ft. Dia. 16 in. to 225 ft. depth Wall Thickness: inches or Dia. _____ in. to _____ ft. depth gage No. 219		
					10. Screen: Manufacturer's name _____ Lakewood Type Millslot Dia. 16" 1/8x2" Length 54 Set between 171 ft. and 225 ft. _____ ft. and _____ ft. Gravel pack? Yes Size range of material 1/8x3/16		
					11. Static water level: _____ mo./day/yr. 189 ft. below land surface Date 11-8-77		
					12. Pumping level below land surfaces: 217 ft. after 6 hrs. pumping 80 g.p.m. _____ ft. after _____ hrs. pumping _____ g.p.m. Estimated maximum yield _____ g.p.m. 80		
					13. Water sample submitted: _____ mo./day/yr. Yes <input type="checkbox"/> No <input checked="" type="checkbox"/> Date _____		
					14. Well head completion: _____ <input type="checkbox"/> Pitless adapter 12 inches above grade		
					15. Well grouted? Yes With: <input type="checkbox"/> Neat cement <input type="checkbox"/> Bentonite <input checked="" type="checkbox"/> Concrete Depth: From 0 ft. to 10 ft.		
					16. Nearest source of possible contamination: _____ NA ft. _____ Direction _____ Type _____ Well disinfected upon completion? _____ Yes <input checked="" type="checkbox"/> No		
					17. Pump: <input checked="" type="checkbox"/> Not installed Manufacturer's name _____ Model number _____ HP _____ Volts _____ Length of drop pipe _____ ft. capacity _____ g.p.m. Type: <input type="checkbox"/> Submersible <input type="checkbox"/> Turbine <input type="checkbox"/> Jet <input type="checkbox"/> Reciprocating <input type="checkbox"/> Centrifugal <input type="checkbox"/> Other		
			(Use a second sheet if needed)				
18. Elevation:		19. Remarks:			20. Water well contractor's certification:		
Topography: <input type="checkbox"/> Hill <input type="checkbox"/> Slope <input checked="" type="checkbox"/> Upland <input type="checkbox"/> Valley		This well is completed but the pump is not installed. We are bringing our records up to date High Plains Drilling & Supply, Inc 136A so are sending this well report in now, and the pumps to be installed later.			This well was drilled under my jurisdiction and this report is true to the best of my knowledge and belief. Business name _____ License No. _____ Address Garden City, Ks. 67846 Signed Barthelme Date 4/29/80 Authorized representative		

T 22
R 38
W E
13
Sec
1/4
1/4
1/4
1/4
Summers