

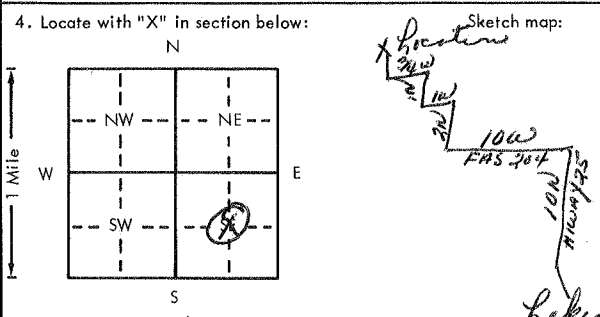
USE TYPEWRITER OR BALL POINT PEN-PRESS FIRMLY, PRINT CLEARLY.

WATER WELL RECORD
KSA 82a-1201-1215

Kansas Department of Health and Environment-Division of Environment (Water well Contractors) Topeka, Kansas 66620

CWW Inv. # 13087

Bontrager #1

1. Location of well:	County Kearney	Fraction 1/4 SE 1/4 SE 1/4	Section number 15	Township number T 22 S R 38 E/W	Range number 38
2. Distance and direction from nearest town or city: 10 mi. north of Lakin, 1 west, 2 North, 1 west, 1 north west. Street address of well location if in city:			3. Owner of well: Rains & Williamson Oil Co., Inc. R.R. or street: 435 Page Court, 220 West Douglas City, state, zip code: Wichita, Kansas 67202		
4. Locate with "X" in section below: 			6. Bore hole dia. 9 in. Completion date 1-17-77 Well depth 220 ft.		
5. Type and color of material			7. <input type="checkbox"/> Cable tool <input checked="" type="checkbox"/> Rotary <input type="checkbox"/> Driven <input type="checkbox"/> Dug <input type="checkbox"/> Hollow rod <input type="checkbox"/> Jetted <input type="checkbox"/> Bored <input type="checkbox"/> Reverse rotary		
Surface			8. Use: <input type="checkbox"/> Domestic <input type="checkbox"/> Public supply <input type="checkbox"/> Industry <input type="checkbox"/> Irrigation <input type="checkbox"/> Air conditioning <input type="checkbox"/> Stock <input type="checkbox"/> Lawn <input checked="" type="checkbox"/> Oil field water <input type="checkbox"/> Other		
Clay			9. Casing: Material _____ Height: Above or below Threaded _____ Welded _____ Surface 28 in. RMP 5 _____ PVC 135 <input checked="" type="checkbox"/> Weight 2.78 lbs./ft. Dia. 5 in. to _____ ft. depth Wall Thickness: inches or Dia. 5 in. to 220 ft. depth gage No. 265		
Fine sand & Med. to large sand			10. Screen: Manufacturer's name _____ sawed perf. Type PVC Dia. 5" Slot/gauze _____ Length 80" Set between 135 ft. and 215 ft. Gravel pack? <input checked="" type="checkbox"/> yes Size range of material: 1/8 to 3/16		
Clay			11. Static water level: _____ mo./day/yr. 166 ft. below land surface Date 1-17-77		
			12. Pumping level below land surfaces: _____ ft. after _____ hrs. pumping _____ g.p.m. _____ ft. after _____ hrs. pumping _____ g.p.m. Estimated maximum yield 40 g.p.m.		
			13. Water sample submitted: _____ mo./day/yr. <input type="checkbox"/> Yes <input checked="" type="checkbox"/> No Date _____		
			14. Well head completion: <input type="checkbox"/> Pitless adapter 28 Inches above grade		
			15. Well grouted? <input checked="" type="checkbox"/> yes With: <input checked="" type="checkbox"/> Neat cement <input type="checkbox"/> Bentonite <input type="checkbox"/> Concrete Depth: From 0 ft. to 10 ft.		
			16. Nearest source of possible contamination: ft. 100 Direction NE Type oilwell Well disinfected upon completion? <input checked="" type="checkbox"/> Yes <input type="checkbox"/> No		
			17. Pump: <input checked="" type="checkbox"/> Not installed Manufacturer's name _____ Model number _____ HP _____ Volts _____ Length of drop pipe _____ ft. capacity _____ g.p.m. Type: <input type="checkbox"/> Submersible <input type="checkbox"/> Turbine <input type="checkbox"/> Jet <input type="checkbox"/> Reciprocating <input type="checkbox"/> Centrifugal <input type="checkbox"/> Other		
18. Elevation:			20. Water well contractor's certification: This well was drilled under my jurisdiction and this report is true to the best of my knowledge and belief. Carlile Water Well 118 Business name License No. _____ Address Box 275, Liberal, Ks Signed Edward E. Means Date 1-28 Authorized representative		
19. Remarks:					

Forward the white, blue and pink copies to the Department of Health and Environment

Form WWC-5