

—Log Of Test Well— No 1



Date of Test 2/6/56

Customer Carl Balzer

Address Inman, Kansas

Location N.E. 1/4 222 - 40 Range Co.

Static Water Level

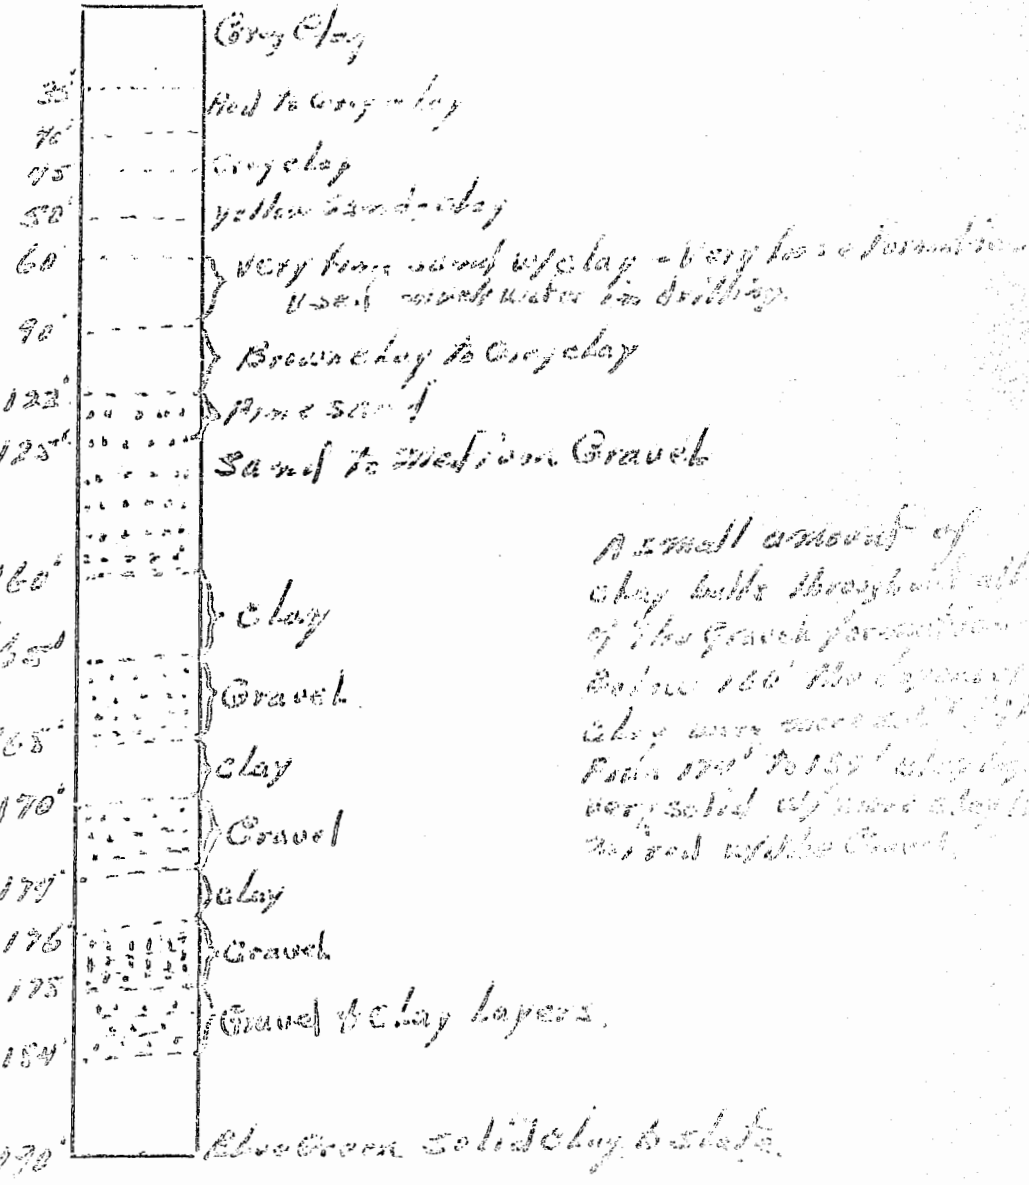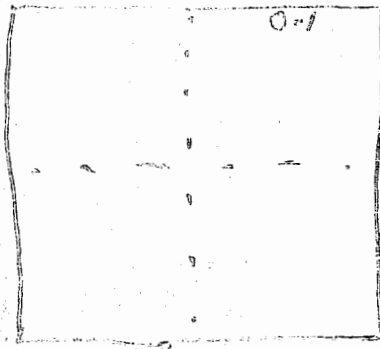

40' Water Brg.

W.B.

W.B.

10' W.B.

A small amount of clay balls throughout all of the gravel formation. Below 160' the layers of clay were more solid. The beds 170' to 184' clay is very solid w/ more clay ball mixed w/ the gravel.

Ad by ch
2-9-56

[Handwritten signature]