

Phone 24

ANDERSEN & DARLING
JAMESTOWN, KANSAS

Phone 705

—Log Of Test Well— 7102—



Date of Test 2-14-56

Customer Carl Balzer

Address Inman, Kans

Location NE 1/4 2-22-7 Reno Co.

Static Water Level

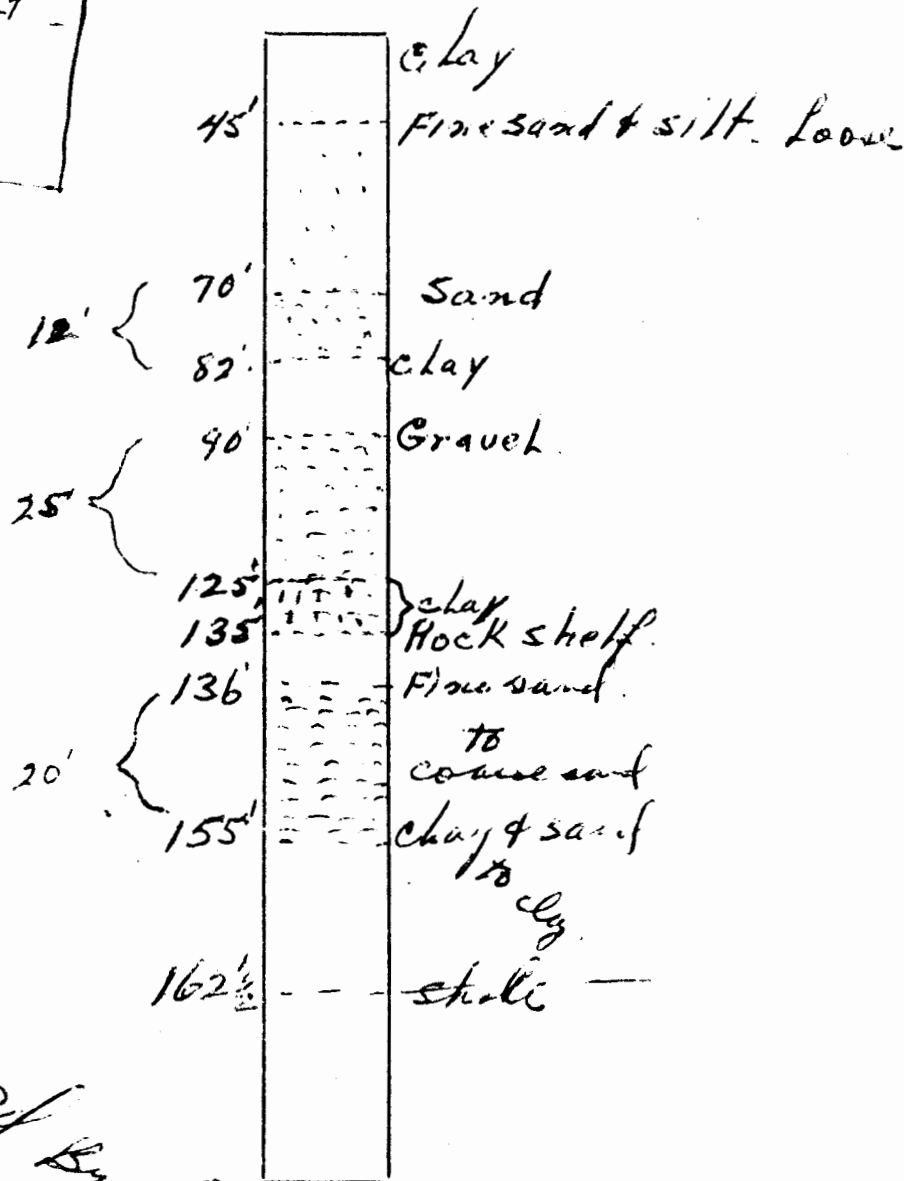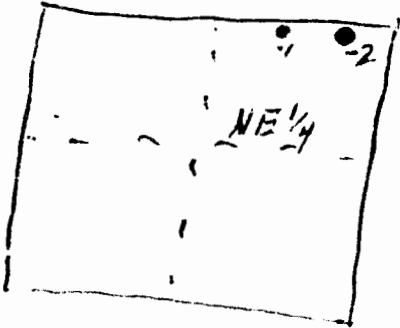

PA By ck.
2-14-56

Harry Anderson