

Andersen & Darling


Jamestown, Kansas

Carl Balzer
 Inman, Kans.

Completion of Irrigation Well

- construction -

Date of Completion -
 2-22-56

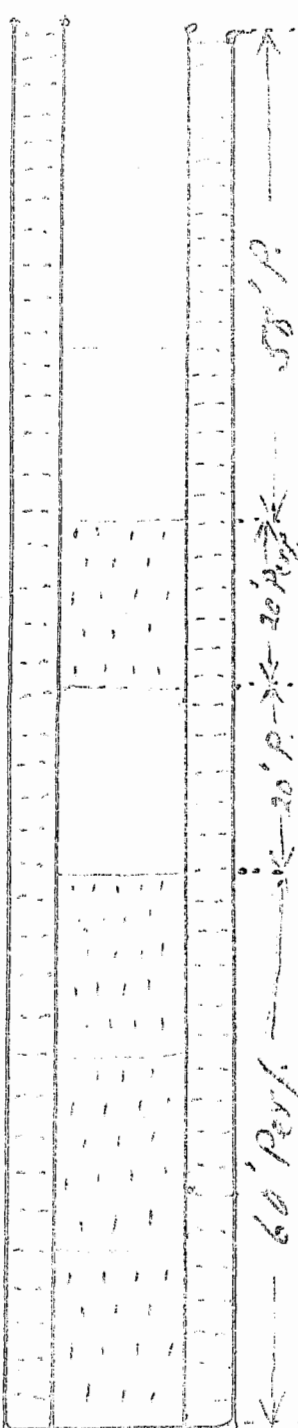

3 1/2" dia Bored well.

9" spacing Gravel Picked

Plain	55'	10 gauge	Bitum. Asphalt dipst.	Equal 2" spacing (E)
Perf	20'	10 "	"	"
Plain	20'	10 "	"	"
Perf	66'	10 "	"	"

Welded joints. Asphalt coated.

10 gauge steel. welded Bottom

- Test pumped for G.P.M.

31' 6" static water level

35' 6" Pumped 250 GPM.

39' " 480 "

40' " 600 "

45' " 900 "

Total Depth 178'

WELL DRILLER'S PUMP AND WELL CONTRACT
COMPLETION SHEET

Date 2-24-56

CUSTOMERS NAME Carl Balacc
 CUSTOMERS POST OFFICE ADDRESS Inman House
 LOCATION OF WELL 5 miles South of Central of Inman House

WELL FINISHED 178' FT. DEEP
 NUMBER OF FEET OF PLAIN CASING 78' GAUGE 1 1/2" round DIAMETER 18"
 NUMBER OF FEET OF PERFORATED CASING 80' GAUGE 1 1/2" " DIAMETER 18"
 NUMBER OF FEET OF SCREEN CASING _____ GAUGE _____ DIAMETER _____

SPECIFICATIONS OF PUMP: HEAD NUMBER Latex _____
 LENGTH OF COLUMN PIPE AND SIZE 3"
 NUMBER OF BOWLS 4-10" Bow OF BOWLS _____

ADDITIONAL SUCTION PIPE 5' GAUGE _____ DIA. _____
 YARDS OF GRAVEL 36 yds.
 NUMBER OF ADDITIONAL TESTS RUN _____
 COSTS OF ADDITIONAL TESTS _____

NAME OF TEST WELL DRILLER _____
 ADDITIONAL REMARKS _____

ESTIMATED G.P.A. 2.50 GPM 3.5'
480 " 34'
600 " 32'
900 "

NOTE: Please fill in after we for pay
 COPY FOR YOUR FILES, send on file.

7/9/53