


1 LOCATION OF WATER WELL:	Fraction	Section Number	Township Number	Range Number
County: Reno	SW $\frac{1}{4}$ NW $\frac{1}{4}$ NW $\frac{1}{4}$	16	22	4 EW

Distance and direction from nearest town or city street address of well if located within city?
 730 N. Buhler Road, Buhler

2 WATER WELL OWNER: Unified School District #313 730 N. Buhler Road RR #, St. Address, Box #: Buhler, KS 67522 City, State, ZIP Code :	Board of Agriculture, Division of Water Resources Application Number:
---	--

3 MARK WELL'S LOCATION WITH AN "X" IN SECTION BOX:	4 DEPTH OF WELL 14.8 ft. WELL'S STATIC WATER LEVEL N/A ft. WELL WAS USED AS: <table style="width:100%; border: none;"> <tr> <td>1 Domestic</td> <td>5 Public Water Supply</td> <td>9 Dewatering</td> </tr> <tr> <td>2 Irrigation</td> <td>6 Oil Field Water Supply</td> <td>10 Monitoring Well</td> </tr> <tr> <td>3 Feedlot</td> <td>7 Domestic (Lawn & Garden)</td> <td>11 Injection Well</td> </tr> <tr> <td>4 Industrial</td> <td>8 Air Conditioning</td> <td>● Other Soil vapor observation.....</td> </tr> </table> <p>Was a chemical / bacteriological sample submitted to Department? Yes No <input checked="" type="checkbox"/> If yes, mo/day/yr sample was submitted</p> <p>Water Well Disinfected: Yes No <input checked="" type="checkbox"/></p>	1 Domestic	5 Public Water Supply	9 Dewatering	2 Irrigation	6 Oil Field Water Supply	10 Monitoring Well	3 Feedlot	7 Domestic (Lawn & Garden)	11 Injection Well	4 Industrial	8 Air Conditioning	● Other Soil vapor observation.....
1 Domestic	5 Public Water Supply	9 Dewatering											
2 Irrigation	6 Oil Field Water Supply	10 Monitoring Well											
3 Feedlot	7 Domestic (Lawn & Garden)	11 Injection Well											
4 Industrial	8 Air Conditioning	● Other Soil vapor observation.....											

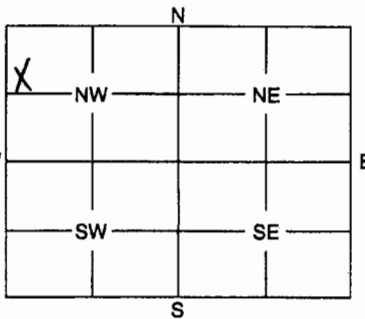

5	TYPE OF BLANK CASING USED:	1 Steel 3 RMP (SR) 5 Wrought 7 Fiberglass 9 Other (Specify below) ● PVC 4 ABS 6 Asbestos-Cement 8 Concrete Tile	
Blank casing diameter 2 in.		Was casing pulled? Yes <input checked="" type="checkbox"/> No	If yes, how much 14.8' *
Casing height above or below land surface 0 in.			

6	GROUT PLUG MATERIAL:	1 Neat cement 2 Cement grout ● Bentonite ● Other ..Native soil..... Grout Plug Intervals: From 0 ft. to 2 ft., From 2 ft. to 15 ft., From to ft.																					
What is the nearest source of possible contamination:																							
<table style="width:100%; border: none;"> <tr> <td>1 Septic tank</td> <td>6 Seepage pit</td> <td>11 Fuel storage</td> <td>16 Other (specify below)</td> </tr> <tr> <td>2 Sewer lines</td> <td>7 Pit privy</td> <td>12 Fertilizer storage</td> <td></td> </tr> <tr> <td>3 Watertight sewer lines</td> <td>8 Sewage lagoon</td> <td>13 Insecticide storage</td> <td></td> </tr> <tr> <td>4 Lateral lines</td> <td>9 Feedyard</td> <td>14 Abandoned water well</td> <td></td> </tr> <tr> <td>5 Cess pool</td> <td>10 Livestock pens</td> <td>15 Oil well/Gas well</td> <td></td> </tr> </table>				1 Septic tank	6 Seepage pit	11 Fuel storage	16 Other (specify below)	2 Sewer lines	7 Pit privy	12 Fertilizer storage		3 Watertight sewer lines	8 Sewage lagoon	13 Insecticide storage		4 Lateral lines	9 Feedyard	14 Abandoned water well		5 Cess pool	10 Livestock pens	15 Oil well/Gas well	
1 Septic tank	6 Seepage pit	11 Fuel storage	16 Other (specify below)																				
2 Sewer lines	7 Pit privy	12 Fertilizer storage																					
3 Watertight sewer lines	8 Sewage lagoon	13 Insecticide storage																					
4 Lateral lines	9 Feedyard	14 Abandoned water well																					
5 Cess pool	10 Livestock pens	15 Oil well/Gas well																					
Direction from well?		How many feet?																					

FROM	TO	PLUGGING MATERIALS
0	2	Native soil
2	15	Bentonite (8")

*Drilled out to 15'
SVO2
GeoCore #81

7	CONTRACTOR'S OF LANDOWNER'S CERTIFICATION: This water well was plugged under my jurisdiction and was completed on (mo/day/year) 7/10/2006 and this record is true to the best of my knowledge and belief. Kansas Water Well Contractor's License No. 527 This Water Well Record was completed on (mo/day/year) 7/24/2006 under the business name of Geocore, Inc. by (signature) Dale Holt		
---	---	--	--

INSTRUCTIONS: Use typewriter or ball point pen. Please press firmly and print clearly. Please fill in blanks, underline or circle the correct answers. Send top three copies to Kansas Department of Health and Environment, Bureau of Water, Geology Section, 1000 SW Jackson St., Ste. 420, Topeka, Kansas 66612-1367. Telephone: 785/296-5522. Send one to Water Well Owner and retain one for your records.