

CORRECTION(S) TO WATER WELL RECORD (WWC-5)

(to rectify lacking or incorrect information)

Location listed as:

Section-Township-Range: 22-22 S-4 W

Fraction ( 1/4 1/4 1/4): None Given

County: Reno

Location changed to:

22-22 S-4 W

NW NW NW

Other changes: Initial statements: \_\_\_\_\_

Changed to: \_\_\_\_\_

Comments: Well owner's street address is

11309 E. 69<sup>th</sup> Ave., Buhler, KS 67522.

verification method: written & legal descriptions, well owner's address,  
area road map, and mapping tool & aerial photos on

KGS website. initials: ERL date: 9/13/2007


submitted by: Kansas Geological Survey, Data Resources Library, 1930 Constant Ave., Lawrence, KS 66047-3726

to: Kansas Dept of Health & Environment, Bureau of Water, 1000 SW Jackson, Suite 420, Topeka, KS 66612-1367.

1	LOCATION OF WATER WELL:	Fraction	Section Number	Township Number	Range Number
County:	Reno	1/4 1/4 1/4	22	22 S	4W

Distance and direction from nearest town or city street address of well if located within city?  
 1/2 mile South & 1/2 mile East of Buhler 69th & Victory

2 WATER WELL OWNER: Steven R. Becker  
 RR#, St. Address, Box #: PO Box 384  
 City, State, ZIP Code: Buhler, KS 67522  
 Board of Agriculture, Division of Water Resources  
 Application Number:

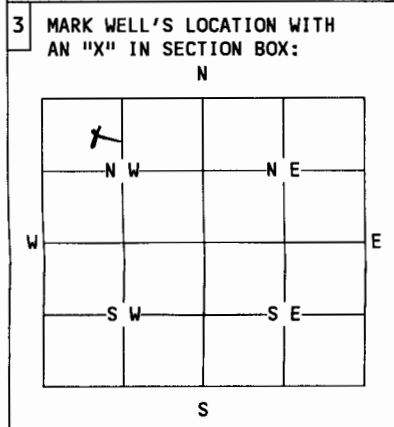

4 DEPTH OF WELL..... 5.0 .....ft.  
 WELL'S STATIC WATER LEVEL..... 29.5 .....ft.  
 WELL WAS USED AS:  
 1 Domestic  5 Public Water Supply  9 Dewatering  
 2 Irrigation  6 Oil Field Water Supply  10 Monitoring Well  
 3 Feedlot  7 Lawn and Garden Only  11 Injection Well  
 4 Industrial  8 Air Conditioning  12 Other.....  
 Was a chemical/bacteriological sample submitted to Department? Yes....No.   
 If yes, mo/day/yr sample was submitted.....  
 Water Well Disinfected: Yes.  No.....

5 TYPE OF BLANK CASING USED:

1 Steel	3 RMP (SR)	5 Wrought	7 Fiberglass	9 Other (specify below)
<input checked="" type="radio"/> 2 PVC	4 ABS	6 Asbestos-Cement	8 Concrete Tile	

Blank casing diameter..... 6 in. Was casing pulled? Yes.  No..... If yes, how much. 3ft.  
 Casing height above or below land surface..... 36 in.

6 GROUT PLUG MATERIAL: 1 Neat cement 2 Cement grout  3 Bentonite 4 Other.....  
 Grout Plug Intervals: From.. 3 ft. to.. 50 ft., From.....ft. to .....ft., From..... to.....ft.  
 What is the nearest source of possible contamination:  
 1 Septic tank 6 Seepage pit 11 Fuel storage 16 Other (specify below)  
 2 Sewer lines 7 Pit privy 12 Fertilizer storage  
 3 Watertight sewer lines 8 Sewage lagoon 13 Insecticide storage  
 4 Lateral lines 9 Feedyard 14 Abandoned water well  
 5 Cess Pool 10 Livestock pens 15 Oil well/Gas well  
 Direction from well? .. South..... How many feet? 60.....

FROM	TO	PLUGGING MATERIALS
3	50	Bentonite

7 CONTRACTOR'S OR LANDOWNER'S CERTIFICATION: This water well was plugged under my jurisdiction and was completed on (mo/day/year) 8-30-07 and this record is true to the best of my knowledge and belief. Kansas Water Well Contractor's License No. .... This Water Well Record was completed on (mo/day/year) ..... under the business name of ..... by (signature) Steven R. Becker

INSTRUCTIONS: Use typewriter or ball point pen. Please press firmly and print clearly. Please fill in blanks, underline or circle the correct answers. Send top three copies to Kansas Department of Health and Environment, Bureau of Water, Topeka, Kansas 66620-0001. Telephone: 913/296-3565. Send one to Water Well Owner and retain one for your records.