


1 LOCATION OF WATER WELL: County: <b>Reno</b>	Fraction <b>NE 1/4 SE 1/4 NE 1/4</b>	Section Number <b>17</b>	Township Number <b>T 22 S</b>	Range Number <b>R 4 E</b>
--	---	-----------------------------	----------------------------------	------------------------------

Distance and direction from nearest town or city street address of well if located within city?  
**101 S. Main, Buhler**

2 WATER WELL OWNER: **Mid Kansas Coop Association**  
 RR#, St. Address, Box # : **Box 286**  
 City, State, ZIP Code : **Buhler, Kansas 67522**  
 Board of Agriculture, Division of Water Resources  
 Application Number:

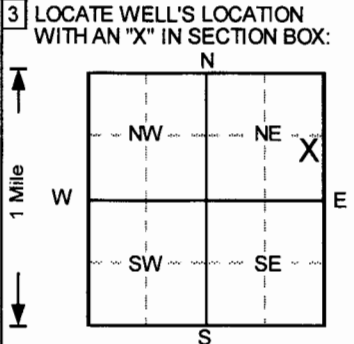

4 DEPTH OF COMPLETED WELL ..... **20** ..... ft. ELEVATION: ..... **1479.89** .....  
 Depth(s) Groundwater Encountered 1. .... ft. 2. .... ft. 3. .... ft.  
 WELL'S STATIC WATER LEVEL ... **8.15** ... ft. below land surface measured on mo/day/yr ... **9/26/2007** ...  
 Pump test data: Well water was ... **NA** ... ft. after ..... hours pumping ..... gpm  
 Est. Yield ... **NA** ... gpm: Well water was ..... ft. after ..... hours pumping ..... gpm  
 Bore Hole Diameter ... **8** ... in. to ... **20** ... ft., and ..... in. to ..... ft.  
 WELL WATER TO BE USED AS: 5 Public water supply 8 Air conditioning 11 Injection well  
 1 Domestic 3 Feedlot 6 Oil field water supply 9 Dewatering 12 Other (Specify below)  
 2 Irrigation 4 Industrial 7 Lawn and garden only **10** Monitoring well  
 Was a chemical/bacteriological sample submitted to Department? Yes.....No ; If yes, mo/day/yr sample was submitted  
 Water Well Disinfected? Yes No

5 TYPE OF BLANK CASING USED: 5 Wrought iron 8 Concrete tile CASING JOINTS: Glued ..... Clamped .....  
 1 Steel 3 RMP (SR) 6 Asbestos-Cement 9 Other (specify below) Welded .....  
**2** PVC 4 ABS 7 Fiberglass ..... Threaded.   
 Blank casing diameter ..... **2** ..... in. to ..... **5** ..... ft., Dia ..... in. to ..... ft., Dia ..... in. to ..... ft.  
 Casing height above land surface ..... **-66** ..... in., weight ..... lbs./ft. Wall thickness or gauge No. ... **Sch. 40** ...  
 TYPE OF SCREEN OR PERFORATION MATERIAL **7** PVC 10 Asbestos-cement  
 1 Steel 3 Stainless steel 5 Fiberglass **8** RMP (SR) 11 Other (specify) .....  
 2 Brass 4 Galvanized steel 6 Concrete tile 9 ABS 12 None used (open hole)  
 SCREEN OR PERFORATION OPENINGS ARE: 5 Gauzed wrapped 8 Saw cut 11 None (open hole)  
 1 Continuous slot **3** Mill slot 6 Wire wrapped 9 Drilled holes  
 2 Louvered shutter 4 Key punched 7 Torch cut 10 Other (specify) .....  
 SCREEN-PERFORATED INTERVALS: From ..... **5** ..... ft. to ..... **20** ..... ft., From ..... ft. to ..... ft.  
 From ..... ft. to ..... ft., From ..... ft. to ..... ft.  
 GRAVEL PACK INTERVALS: From ..... **4** ..... ft. to ..... **20** ..... ft., From ..... ft. to ..... ft.  
 From ..... ft. to ..... ft., From ..... ft. to ..... ft.

6 GROUT MATERIAL: 1 Neat cement **2** Cement grout **3** Bentonite 4 Other .....  
 Grout Intervals: From ..... **0** ..... ft. to ..... **2** ..... ft., From ..... **2** ..... ft. to ..... **4** ..... ft., From ..... ft. to ..... ft.  
 What is the nearest source of possible contamination:  
 1 Septic tank 4 Lateral lines 7 Pit privy 10 Livestock pens 14 Abandoned water well  
 2 Sewer lines 5 Cess pool 8 Sewage lagoon 11 Fuel storage 15 Oil well/Gas well  
 3 Watertight sewer lines 6 Seepage pit 9 Feedyard 12 Fertilizer storage 16 Other (specify below)  
 13 Insecticide storage .....  
 Direction from well? How many feet?

FROM	TO	LITHOLOGIC LOG	FROM	TO	PLUGGING INTERVALS
0	0.5	Asphalt,			
0.5	1.5	Clay and Sand (fill),			
1.5	4.5	Clay, sl. silty, moist, plastic, no odor, Brown			
4.5	10.5	Clay, silty, moist, plastic, no odor, Yellow-Bro			
10.5	15	Clay, saturated, soft, no odor, Yellow-Brown			
15	20	Clay, silty, saturated stringers, no odor, Lt. Re			
<b>CORRECTED</b>					
MW13 , Tag # 0041442 , Flushmount					
Project Name: Mid Kansas Coop - Buhler Bulk Fuel - Mo					
GeoCore # 635 , KDHE # U2 078 40040					

7 CONTRACTOR'S OR LANDOWNER'S CERTIFICATION: This water well was **(1)** constructed, (2) reconstructed, or (3) plugged under my jurisdiction and was completed on (mo/day/year) ..... **8/31/2007** ..... and this record is true to the best of my knowledge and belief.  
 Kansas Water Well Contractor's License No. .... **527** ..... This Water Well Record was completed on (mo/day/yr) ..... **9/5/2007** .....  
 under the business name of **GeoCore, Inc.** by (signature) *Don Wolf*

OFFICE USE ONLY

T

R

EW

SEC.

1/4

1/4

1/4