


1 LOCATION OF WATER WELL: Fraction 1/4 SE 1/4 NW 1/4 NE 1/4 Section Number 14 Township Number T 22 S Range Number 4 E W
 County: Reno

Street/Rural Address of Well Location; if unknown, distance & direction from nearest town or intersection: If at owner's address, check here Approximately 2.25 miles east of Buhler, KS

2 WATER WELL OWNER: Leon Gaeddert
 RR#, St. Address, Box #: 13209 E. 82nd Ave.
 City, State ZIP Code: Buhler, KS 67522

Global Positioning Systems (GPS) information:
 Latitude: 38.14252 (in decimal degrees)
 Longitude: -97.72617 (in decimal degrees)
 Elevation: _____
 Datum: WGS84, NAD83, NAD27
 Collection Method:
 GPS unit (Make/Model: Garmin GPSmap 60CSx)
 Digital Map/Photo, Topographic Map, Land Survey
 Est. Accuracy: < 3 m, 3-5 m, 5-15 m, > 15 m

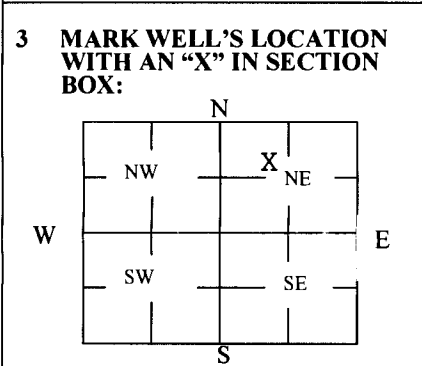

4 DEPTH OF WELL 130 ft.
 WELL'S STATIC WATER LEVEL 45.2 ft.
 WELL WAS USED AS:
 Domestic Public Water Supply Dewatering
 Irrigation Oil Field Water Supply Monitoring
 Feedlot Domestic (Lawn & Garden) Injection Well
 Industrial Air Conditioning Other _____
 Was a chemical/bacteriological sample submitted to Department? Yes No

5 TYPE OF BLANK CASING USED:

Steel RMP (SR) Wrought Fiberglass Other (Specify below) _____
 PVC ABS Asbestos-Cement Concrete Tile

Blank casing diameter 16 in. Was casing pulled? Yes No If yes, how much _____
 Casing height above or below land surface below 36 in.

6 GROUT PLUG MATERIAL: Neat cement Cement grout Bentonite Other _____

Grout Plug Intervals: From 45.2 ft. to 3 ft., From _____ ft. to _____ ft., From _____

What is the nearest source of possible contamination:
 Septic tank Seepage pit Fuel Storage Other (specify below) _____
 Sewer lines Pit privy Fertilizer storage
 Watertight sewer lines Sewage lagoon Insecticide storage
 Lateral lines Feedyard Abandoned water well
 Cess pool Livestock pens Oil well/Gas well

Direction from well? East **Equus Beds Groundwater Management District No. 2**
 How many feet? approximately 100 feet

RECEIVED
APR 25 2013

FROM	TO	PLUGGING MATERIALS	FROM	TO	PLUGGING MATERIALS
130	45.2	Clean, coarse sand			Well plugging witnessed by
45.2	3	Cement grout			D. Randolph, GMD2 staff, on
3	0	Topsoil			11-7-2012 and 12-14-2012
					Well casing removed 3 feet below
					land surface on 4-1-2013

7 CONTRACTOR'S OR LANDOWNER'S CERTIFICATION: This water well was plugged under my jurisdiction and was completed on (mo/day/year) 4-1-2013 and this record is true to the best of my knowledge and belief. Kansas Water Well Contractor's License No. _____. This Water Well Record was completed on (mo/day/year) 4-17-2013 under the business name of _____ by (signature) Leon Gaeddert

INSTRUCTIONS: Use typewriter or ballpoint pen. Please press firmly and print clearly. Please fill in blanks, underline or circle the correct answers. Send top three copies to Kansas Department of Health and Environment, Bureau of Water, Geology Section, 1000 SW Jackson St., Ste. 420, Topeka, Kansas 66612-1367. Telephone: 785/296-5524. Send one to Water Well Owner and retain one for your records. Visit us at <http://www.kdheks.gov/waterwell/index.html>.

Check one: White Copy Blue Copy Pink Copy