

WATER WELL RECORD


Form WWC-5

Division of Water Resources App. No.

1 LOCATION OF WATER WELL: County: Reno Fraction 1/4 SW 1/4 NE 1/4 SE 1/4 Section Number 13 Township No. T 22 S Range Number R 4 [] E [X] W

Street/Rural Address of Well Location; if unknown, distance & direction from nearest town or intersection: If at owner's address, check here []. From Buhler 4 E. 3/4 S. WSR Global Positioning System (GPS) information: Latitude: ... Longitude: ... Elevation: ... Datum: [] WGS 84, [] NAD 83, [] NAD 27 Collection Method: [] GPS unit (Make/Model: ...) [] Digital Map/Photo, [] Topographic Map, [] Land Survey Est. Accuracy: [] <3 m, [] 3-5 m, [] 5-15 m, [] >15 m

2 WATER WELL OWNER: Phil Schmidt RR#, Street Address, Box #: 21827 West Dutch Ave. City, State, ZIP Code : Buhler, Kansas 67522

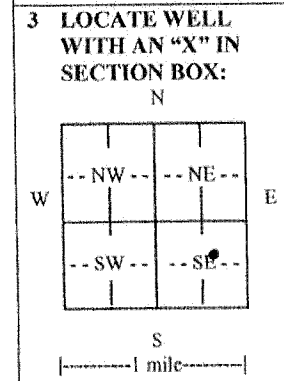

4 DEPTH OF COMPLETED WELL 135 ft. Depth(s) Groundwater Encountered (1) ... ft. (2) ... ft. (3) ... ft. WELL'S STATIC WATER LEVEL 38 ft. below land surface measured on mo/day/yr. 5-11-2013. Pump test data: Well water was ... ft. after ... hours pumping ... gpm EST. YIELD ... gpm. Well water was ... ft. after ... hours pumping ... gpm Bore Hole Diameter 40 in. to 135 ft., and ... in. to ... ft. WELL WATER TO BE USED AS: [] Public water supply [] Geothermal [] Injection well [] Domestic [] Feedlot [] Oil field water supply [] Dewatering [] Other (Specify below) [X] Irrigation [] Industrial [] Domestic-lawn & garden [] Monitoring well Was a chemical/bacteriological sample submitted to Department? [] Yes [X] No If yes, mo/day/yr sample was submitted. Water well disinfected? [X] Yes [] No

5 TYPE OF CASING USED: [] Steel [X] PVC [] Other CASING JOINTS: [X] Glued [] Clamped [] Welded [] Threaded Casing diameter .16 in. to .95 ft., Diameter ... in. to ... ft., Diameter ... in. to ... ft. Casing height above land surface .12 in., Weight SCH 40 lbs./ft., Wall thickness or gauge No. 500 TYPE OF SCREEN OR PERFORATION MATERIAL: [] Steel [] Stainless Steel [X] PVC [] Other (Specify) [] Brass [] Galvanized Steel [] None used (open hole) SCREEN OR PERFORATION OPENINGS ARE: [] Continuous slot [] Mill slot [] Gauze wrapped [] Torch cut [] Drilled holes [] None (open hole) [] Louvered shutter [] Key punched [] Wire wrapped [X] Saw cut [] Other (specify) SCREEN-PERFORATED INTERVALS: From .95 ft. to 135 ft., From ... ft. to ... ft. From ... ft. to ... ft. GRAVEL PACK INTERVALS: From 135 ft. to 20 ft., From ... ft. to ... ft. From ... ft. to ... ft.

6 GROUT MATERIAL: [] Neat cement [] Cement grout [X] Bentonite [] Other Grout Intervals: From .20 ft. to .0 ft., From ... ft. to ... ft., From ... ft. to ... ft. What is the nearest source of possible contamination: [] Septic tank [] Lateral lines [] Pit privy [] Livestock pens [] Insecticide storage [X] Other (specify below) [] Sewer lines [] Cesspool [] Sewage lagoon [] Fuel storage [] Abandoned water well [] Watertight sewer lines [] Seepage pit [] Feedyard [] Fertilizer storage [] Oil well/gas well NONE Direction from well Distance from well

Table with columns: FROM, TO, LITHOLOGIC LOG, FROM, TO, LITHO. LOG (cont.) or PLUGGING INTERVALS. Rows: 0-3 Top soil, 3-6 Brown clay-silty, 6-34 Reddish brown clay, 34-45 Tan clay, 45-57 Tan clay-fine sand mix, 57-67 Fine sand, 67-92 Tan clay-fine sand mix, 92-135 Small-fine sand

7 CONTRACTOR'S OR LANDOWNER'S CERTIFICATION: This water well was [X] constructed, [] reconstructed, or [] plugged under my jurisdiction and was completed on (mo/day/year) 5-7-2013 and this record is true to the best of my knowledge and belief. Kansas Water Well Contractor's License No. 134 This Water Well Record was completed on (mo/day/year) 5-15-2013 under the business name of Rosencrantz-Bemis Enterprise by (signature) Daniel A. Jackson

INSTRUCTIONS: Use typewriter or ball point pen. PLEASE PRESS FIRMLY and PRINT clearly. Please fill in blanks and check the correct answers. Send three copies (white, blue, pink) to Kansas Department of Health and Environment, Bureau of Water, Geology Section, 1000 SW Jackson St., Suite 420, Topeka, Kansas 66612-1367. Telephone 785-296-5524. Send one copy to WATER WELL OWNER and retain one for your records. Include fee of \$5.00 for each constructed well. Visit us at http://www.kdheks.gov/waterwell/index.html.