


Rend

NE NE SE NE

17-22-4w

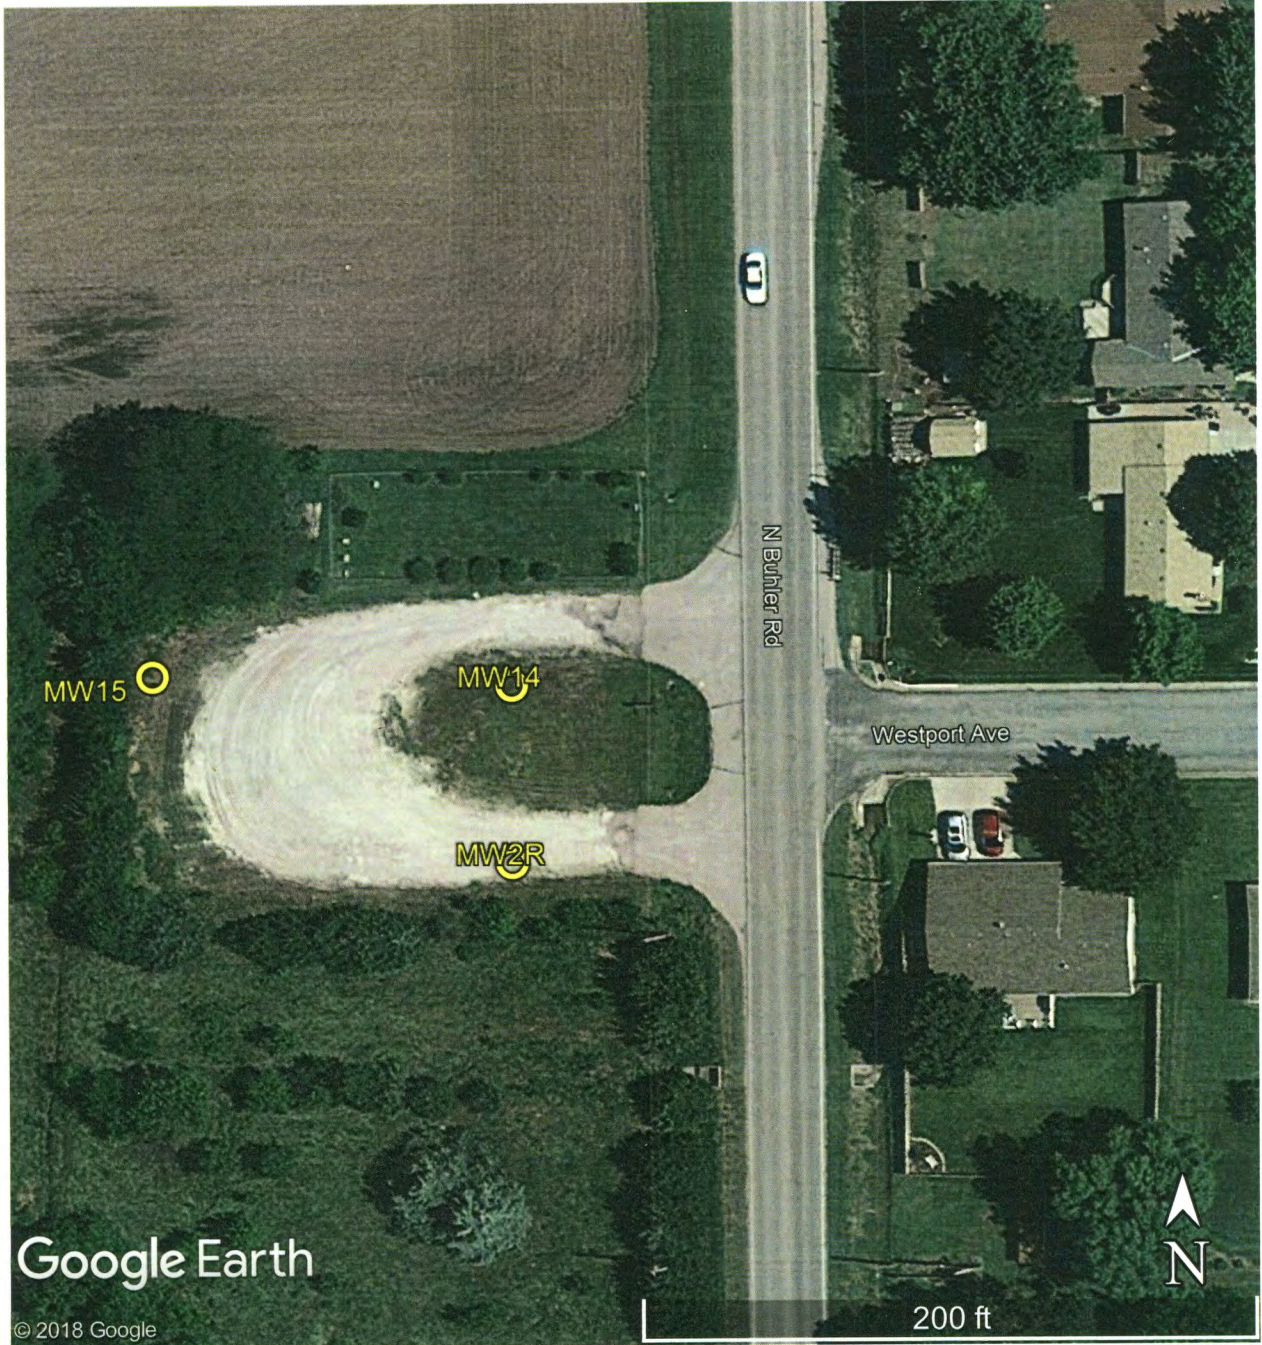

Mid Kansas Coop – Buhler Bulk Fuel
 KDHE #A2 078 40040
 Westport Avenue & Buhler Road, Buhler

GPS Coordinates:

MW2R: 38.14085, -97.77625
 MW14: 38.14101, -97.77625
 MW15: 38.14102, -97.77666

RECEIVED
 OCT 12 2018
 BUREAU OF WATER

RECEIVED
 OCT 12 2018
 BUREAU OF WATER